

SURVEY & REMONUMENTATION

MAY 07 1997

COMMISSION

LAND CORNER RECORDATION CERTIFICATE
Filing Requirement of Act 74, Mich. P.A. 1970


For corners in

Mason Located in: Corner Code #
(County)

1. Public Land Survey T 20N R 17W 1-09
T R
T R
T R

2. Property Controlling in Section S T R
S T R

3. Miscellaneous Property in Sec. S T R
S T R

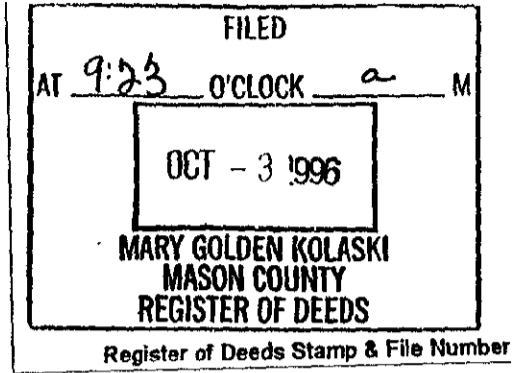

4. Lot No. _____, Recorded Plat _____
5. Private Claims _____

I, Sammy S. Barnett, in a field survey on Sept, 1996 do hereby state that under requirements of P.A. 74, Michigan P.A. of 1970, the corner points mentioned in lines 1 and 2 above were in conformance with regulations and rules therefore as required in the current manual of survey instructions of the United States Department of the Interior, Bureau of Land Management or by a decree of a Court of Law and/or that the corner points mentioned in lines 3, 4 and 5 above were in conformance with the rules of the Michigan Board of Land Surveyors or by a Decree of a Court of Law; established, re-established, monumented, recovered, found as expressed below:

NOTE: Not more than 2 corners, all in the same town and range, may be recorded on this certificate.

| | A | B | C | D | E | F | G | H | I | J | K | L |
|----|----|---|----|---|----|---|----|---|----|---|----|---|
| 1 | | | | | | | | | | | | |
| 2 | 6 | | 5 | | 4 | | 3 | | 2 | | 1 | |
| 3 | | | | | | | | | | | | |
| 4 | 7 | | 8 | | 9 | | 10 | | 11 | | 12 | |
| 5 | | | | | | | | | | | | |
| 6 | 18 | | 17 | | 16 | | 15 | | 14 | | 13 | |
| 7 | | | | | | | | | | | | |
| 8 | 19 | | 20 | | 21 | | 22 | | 23 | | 24 | |
| 9 | | | | | | | | | | | | |
| 10 | 30 | | 29 | | 28 | | 27 | | 26 | | 25 | |
| 11 | | | | | | | | | | | | |
| 12 | 31 | | 32 | | 33 | | 34 | | 35 | | 36 | |
| 13 | | | | | | | | | | | | |

A. Description of original monument and accessories and/or subsequent restoration:
1-09 Corner common to sections 22, 23, 26 & 27, T20N, R17W (Grant)

- 1839 John Brink G.L.O. #4 B. Oak 14" E. 36.0'
- Set post #5 Pine Stump 15" W. 7.0' (#3 ?)
- #1 W. Pine 16" N25F 7 lks. (4.62') 1974 H. Fluharty
- #2 Beech 10" N30W 37 lks. (24.42') Found 1 1/2" pipe at intersection of old fences N.&S. & woods road E. & W.
- 1900 R.O. Towns #6 Oak 20" N80E 26.33
- Monument not given #7 W. Pine 12" N31E 32.66'
- #3 Pine stump 16" N69W 12 lks (7.92') #8 Oak 13" N81W 36.97'
- Undated M.C.R.C records

1978 R. Wetherell Act 132 L.355 P 356
Monument not given
No witnesses

B. Description of corner evidence found and/or method applied in restoring or reestablishing corner:

1-09 Corner common to sections 22, 23, 26 & 27, T20N, R17W (Grant)
On Sept 9, I found 1 1/2" pipe. I found no evidence to dispute this location. The condition of the recorded witnesses are;

- # 1 Gone
- # 2 Gone
- # 3 Gone
- # 6 Oak 24" N87E 26.27' spike in S. side ?
- # 5 Same as # 3
- # 4 Gone
- # 7 W. Pine 16" N38E 32.55' spike in SE side
- # 8 W. Oak 18" N76W 36.88' spike in SW side

C. Description of monument for corner and accessories established to perpetuate locating the position of the corner:
1-09 Corner common to sections 22, 23, 26 & 27, T20N, R17W (Grant)


I replaced, in the exact location, the 1 1/2" pipe with a Standard Mason County Monument and accepted this location as a careful and faithful reestablishment of the original corner.

- # 6 Oak 24" N87E 26.27' spike in S. side ?
- # 7 W. Pine 16" N38E 32.55' spike in SE side
- # 9 Red Oak 17" S35E 59.85'
- # 10 1 1/2" iron pipe 18" above ground N. 0.82'

Corner is 10' E. of pipe line road.

Signed by Sammy S. Barnett
Surveyor's Michigan License No. 16923

Date 9-27-96

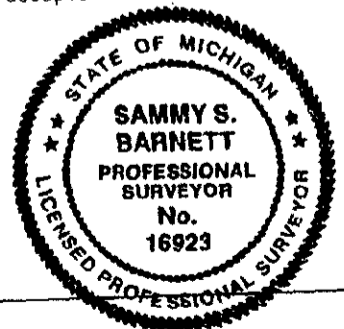

Peer Group Reviewed and Approved
Date: 9-30-96
Kenneth L. Ross
Mason County Surveyor