

**SURVEY &
REMONUMENTATION**


MAY 07 1997

COMMISSION

**LAND CORNER RECORDATION CERTIFICATE
Filing Requirement of Act 74, Mich. P.A. 1970**

For corners in

_____ Mason _____ (County)	Located In:	Corner Code #
1. Public Land Survey	T 20N R 17W	J-07
	T _____ R _____	_____
	T _____ R _____	_____
	T _____ R _____	_____
2. Property Controlling in Section	S _____ T _____ R _____	_____
	S _____ T _____ R _____	_____
3. Miscellaneous Property in Sec.	S _____ T _____ R _____	_____
	S _____ T _____ R _____	_____

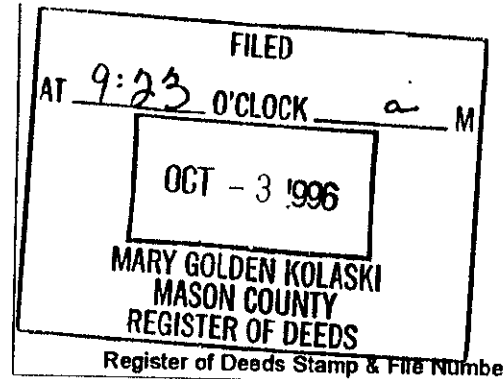

4. Lot No. _____, Recorded Plat _____
5. Private Claims _____

I, Sammy S. Barnett, in a field survey on Sept, 1996 do hereby state that under requirements of P.A. 74, Michigan P.A. of 1970, the corner points mentioned in lines 1 and 2 above were in conformance with regulations and rules therefore as required in the current manual of survey instructions of the United States Department of the Interior, Bureau of Land Management or by a decree of a Court of Law and for that the corner points mentioned in lines 3, 4 and 5 above were in conformance with the rules of the Michigan Board of Land Surveyors or by a Decree of a Court of Law; established, re-established, monumented, recovered, found as expressed below:

NOTE: Not more than 2 corners, all in the same town and range, may be recorded on this certificate.

A	B	C	D	E	F	G	H	I	J	K	L
1											
2	6		5		4		3		2		1
3											
4	7		8		9		10		11		12
5											
6	18		17		16		15		14		13
7											
8	19		20		21		22		23		24
9											
10	30		29		28		27		26		25
11											
12	31		32		33		34		35		36
13											

A. Description of original monument and accessories and/or subsequent restoration:

- J-07 Corner common to sections 14 & 23 T20N, R17W (Grant)
- 1839 John Brink G.L.O.
- Set post #5 Maple 12" N60E 26.68'
- #1 Cedar 10" N14E 14 lks. (9.24')
- 1974 H. Fluharty
- #2 Cedar 11" S12E 13 lks (8.58')
- Monument not given
- 1966 K.B. Stephens
- No witnesses
- Found 1" pipe 6" above surface
- 1977 R. Wetherell
- #3 Basswood 6" S35W 7.0'
- Monument not given
- #4 Twin Maple no size S38E 25.95'
- #6 Triple Maple 9" S42E 26.25 (# 4)
- #7 Twin Maple 13" N56E 26.58' (# 5)
- #8 Maple 15" N29W 36.26'

B. Description of corner evidence found and/or method applied in restoring or reestablishing corner:


- J-07 Corner common to sections 14 & 23 T20N, R17W (Grant)
- On Sept 9, I found the 1" pipe 6" above ground. I found no evidence to dispute this location. The condition of the recorded witnesses are:
- # 1 Gone
- # 2 Gone
- # 3 Basswood 10" N35W 7.31' spike in NW side
- # 4 Triple Maple 12", 10" & 10" S37E 26.30' spike in SE side
- # 5 Maple 20" N60W 26.42' spike in SE side
- # 6 Same as # 4
- # 7 Same as # 5
- # 8 Did not look for

C. Description of monument for corner and accessories established to perpetuate locating the position of the corner:

- J-07 Corner common to sections 14 & 23 T20N, R17W (Grant)
- I replaced the 1" pipe, in the exact location, with a Standard Mason County Monument and accepted this location as a careful and faithful reestablishment of the position of the original corner.
- # 3 Basswood 10" N35W 7.31' spike in NW side
- # 4 Triple Maple 12", 10" & 10" S37E 26.30' spike in SE side
- # 5 Maple 20" N60W 26.42' spike in SE side
- # 9 Maple 7" West 20.18' spike in NE side
- # 10 1" Pipe 2' above ground SE 0.85'

Signed by Sammy S. Barnett
Surveyor's Michigan License No. 16923

Date 9-27-96

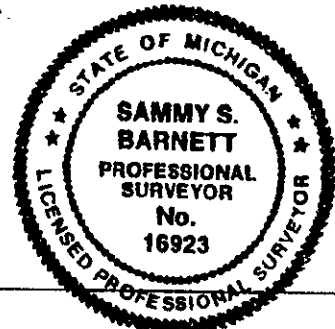

Peer Group Reviewed and Approved
Date: 9-30-96
Kenneth L. Ross
Mason County Surveyor