

**SURVEY & REMONUMENTATION**


MAY 07 1997

**COMMISSION**

**LAND CORNER RECORDATION CERTIFICATE**  
Filing Requirement of Act 74, Mich. P.A. 1970

For corners in

Mason (County)	Located In:	Corner Code #
1. Public Land Survey	T <sup>20N</sup> R <sup>17W</sup>	J-09
	T R	
	T R	
	T R	
2. Property Controlling in Section	S T R	
	S T R	
3. Miscellaneous Property in Sec.	S T R	
	S T R	

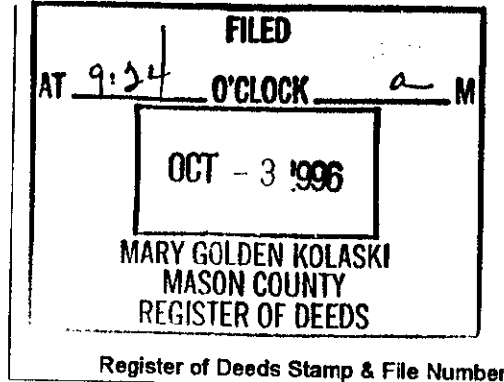

4. Lot No. \_\_\_\_\_, Recorded Plat \_\_\_\_\_  
5. Private Claims \_\_\_\_\_

I, Sammy S. Barnett, in a field survey on Sept, 19 96 do hereby state that under requirements of P.A. 74, Michigan P.A. of 1970, the corner points mentioned in lines 1 and 2 above were in conformance with regulations and rules therefore as required in the current manual of survey instructions of the United States Department of the Interior, Bureau of Land Management or by a decree of a Court of Law and /or that the corner points mentioned in lines 3, 4 and 5 above were in conformance with the rules of the Michigan Board of Land Surveyors or by a Decree of a Court of Law; established, re-established, monumented, recovered, found as expressed below:

NOTE: Not more than 2 corners, all in the same town and range, may be recorded on this certificate.

A	B	C	D	E	F	G	H	I	J	K	L
1											
2	6		5		4		3		2		1
3											
4	7		8		9		10		11		12
5											
6	18		17		16		15		14		13
7											
8	19		20		21		22		23		24
9											
10	30		29		28		27		26		25
11											
12	31		32		33		34		35		36
13											

**A. Description of original monument and accessories and/or subsequent restoration:**

- J-09 Corner common to sections 23 & 26. T20N. R17W (Grant)
- 1839 John Brink G.L.O. #5 Oak 20" N45W 19.02'
- Set post 1974 H. Fluharty
- #1 Beech 10" S20E 42 lks. (27.72') Found 1" pipe on fence line N.S. & W.
- #2 Beech 11" N28W 31 lks (20.46') #6 Poplar 10" S52E 30.08' (#3)
- 1966 K.B. Stephens #7 Twin Maple 12" S32W 19.36' (# 4)
- Found 1" pipe #8 Oak 22" N45W 19.03' (# 5)
- #3 Poplar 6" S49E 30.09'
- #4 Maple 12" S33W 19.40'

- 1978 R. Wetherell Act 132 L. 355. P.356 Monument not given
- #9 Poplar 6" S49E 30.09' (# 3 & 6)
- #10 Maple 12" S33W 19.40' (# 4 & 7)
- #11 Oak 20" N45W 19.02' (# 5 & 8)

**B. Description of corner evidence found and/or method applied in restoring or reestablishing corner:**


- J-09 Corner common to sections 23 & 26. T20N. R17W (Grant)
- On Sept 9. I found the 1" x 28" pipe. I found no evidence to dispute this location. The condition of the recorded witnesses are;
- # 1 Gone # 8 Same as # 5
- # 2 Gone # 9 Same as # 3 & 6
- # 3 Gone # 10 Same as # 4 & 7
- # 4 Maple 22" S37W 19.30' spike in NW side # 11 Same as # 5 & 8
- # 5 W. Oak 26" N38W 19.01' spike in SW side
- # 6 Same as # 3
- # 7 Same as # 4

**C. Description of monument for corner and accessories established to perpetuate locating the position of the corner:**

- J-09 Corner common to sections 23 & 26. T20N. R17W (Grant)
- I replaced the 1" pipe, in the exact location, with a Standard Mason County Monument and accepted this location as a careful and faithful reestablishment of the position of the original corner.
- # 4 Maple 22" S37W 19.30' spike in NW side
- # 5 W. Oak 26" N38W 19.01' spike in SW side
- # 12 Maple 18" N82W 25.71' spike in NE side
- # 13 W. Birch 6" N64E 22.97' spike in SE side

Signed by Sammy S. Barnett  
Surveyor's Michigan License No. 16923

Date 9-27-96

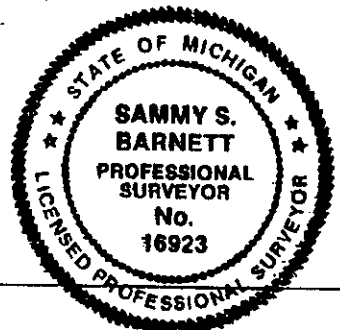

Peer Group Reviewed and Approved.  
Date: 9-26-96  
KeAnith L. Ross  
Mason County Surveyor