

DEC 29 1998

SECTION

LAND CORNER RECORDATION CERTIFICATE

Filing Requirement of Act 74, Mich. P.A. 1970

For corners in
Mason
 (County)

Located In: _____ Corner Code # _____

1. Public Land Survey T 20N R 17W J-13
 T _____ R _____
 T _____ R _____
 T _____ R _____


2. Property Controlling S _____ T _____ R _____
 in Section S _____ T _____ R _____

3. Miscellaneous S _____ T _____ R _____

Property in Sec. S _____ T _____ R _____

4. Lot No. _____, Recorded Plat _____

5. Private Claims _____

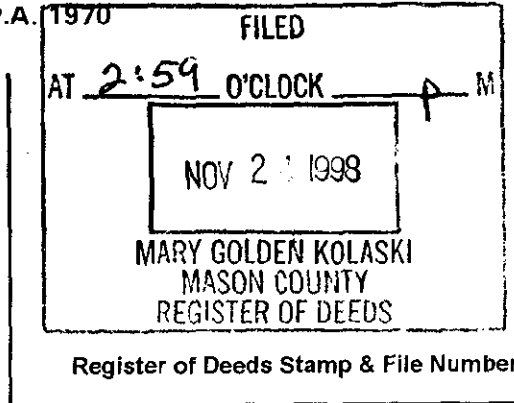

	A	B	C	D	E	F	G	H	I	J	K	L	M
1													
2	6	5	4	3	2	1							
3													
4	7	8	9	10	11	12							
5													
6	18	17	16	15	14	13							
7													
8	19	20	21	22	23	24							
9													
10	30	29	28	27	26	25							
11													
12	31	32	33	34	35	36							
13													

I, Kenneth L. Ross, in a field survey on October 10, 1998, do hereby certify that under requirements of P.A. 74, Michigan P.A. of 1970, the corner points mentioned in lines 1 and 2 above were in conformance with regulations and rules therefore as required in the current manual of survey instructions of the United States Department of the Interior, Bureau of Land Management or by a decree of a Court of Law and/or that the corner points mentioned in lines 3, 4 and 5 above were in conformance with the rules of the Michigan Board of Land Surveyors or by a Decree of a Court of Law, established, re-established, monumented, re-monumented, recovered, found as expressed below:

NOTE: Not more than 4 corners, all in the same town and range, may be recorded on this certificate.

A. Description of original monument and accessories and/or subsequent restoration:
J-13 S 1/4 Corner Section 35, T.20N., R.17W.,

ORIGINAL GOVERNMENT SURVEY

Mullett and Brockfield, 1937 to 1938

Set Post

- (1) Beech, 8", N18°E, 37 links (24.42')
- (2) Beech, 6", N33°W, 11 links (7.26')

MASON COUNTY ROAD COMMISSION

K.B. Stephens, 1966 3/8" iron

- (3) P.P. N47°E, 43.92'
- (4) Guy P. S35°E, 37.77'
- (5) Maple, 10", S05°W, 32.92'
- Joe Borsfay fd. 3/8" iron June, 1974
- Witnesses (3) thru (5) standing

KENNETH L. ROSS, PLS

Tied this corner on a survey dated 4/29/1977 (File H-246) No witnesses given. Corner J-1, T.19N., R.17W., is East, 11.26'

B. Description of corner evidence found and/or method applied in restoring or reestablishing corner:
J-13 S 1/4 Corner Section 35, T.20N., R.17W.,

On October 10, 1998, I found a 1/2" X 24" long Re-bar as a riser to a 3/4" drift Pin.


Condition of record witnesses are as follows: (1) Gone, (2) Gone, (3) found in good condition, (4) found in good condition, (5) found in fair condition.

C. Description of monument for corner and accessories established to perpetuate locating the position of the corner:
J-13 S 1/4 Corner Section 35, T.20N., R.17W.,

I placed a 5/8" X 24" Re-Rod over the 3/4" drift pin with a 3 1/2" Aluminum Cap, Stamped MASON COUNTY MONUMENT about 8" below the surface of the road. This Corner is accepted as a careful and faithful re-establishment of the position of the original corner.

- Ext. "BT" (3) P.P. N 43°E, 43.92", (60d Spike in NW Side)
- Ext. "BT" (4) Guy Pole, S 43°E, 37.77', (60d spike in SW Side)
- Ext. "BT" (5) 24" Maple, S 08°W, 32.79' (60d Spike in West Side)
- (6) 24" Maple, S 17°E, 34.69', (60d Spike in East Side)
- (7) Corner J-1, T.19N., R.17W., East 11.26 feet

Signed by Kenneth L. Ross Date 11-19-98
 Surveyor's Michigan License No. 17634

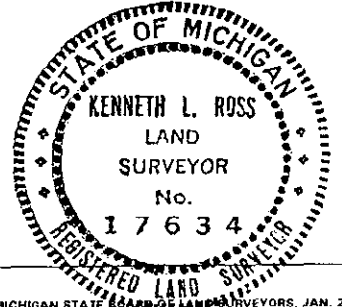

FORM APPROVED BY MICHIGAN STATE BOARD OF LAND SURVEYORS, JAN. 28, 1971
 REVISED MAY 14, 1975
 REVISED JAN., 1983
 ADAPTED FOR WORD PROCESSING MARCH, 1993

Approved by Peer Review Group On 11-19-98
 Kenneth L. Ross, County Representative [Signature]