

SURVEY & REMONUMENTATION

MAY 07 1997

COMMISSION


LAND CORNER RECORDATION CERTIFICATE
Filing Requirement of Act 74, Mich. P.A. 1970

For corners in

MASON
(County)

Located In: Corner Code #

- 1. Public Land Survey T 20N R 17W K-01
T R
T R
T R
- 2. Property Controlling in Section S T R
S T R
- 3. Miscellaneous Property in Sec. S T R
S T R

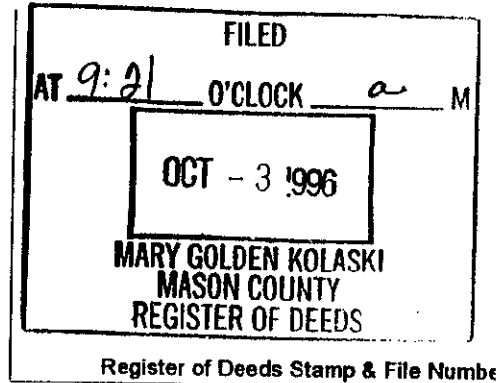

4. Lot No. _____, Recorded Plat _____
5. Private Claims _____

I, Sammy S. Barnett, in a field survey on July 26, 1996 do hereby state that under requirements of P.A. 74, Michigan P.A. of 1970, the corner points mentioned in lines 1 and 2 above were in conformance with regulations and rules therefore as required in the current manual of survey instructions of the United States Department of the Interior, Bureau of Land Management or by a decree of a Court of Law and/or that the corner points mentioned in lines 3, 4 and 5 above were in conformance with the rules of the Michigan Board of Land Surveyors or by a Decree of a Court of Law; established, re-established, monumented, recovered, found as expressed below:

NOTE: Not more than 2 corners, all in the same town and range, may be recorded on this certificate.

1	A	B	C	D	E	F	G	H	I	J	K	L
2		6		5		4		3		2		1
3												
4		7		8		9		10		11		1
5												
6		18		17		16		15		14		1
7												
8		19		20		21		22		23		24
9												
10		30		29		28		27		26		25
11												
12		31		32		33		34		35		36
13												

A. Description of original monument and accessories and/or subsequent restoration:

K-01 Section Corner for Sections 1 and 2, on the County Line, T20N, R17W.

1839, Jonh Brink, G.L.O.
Set Wood Post

#1 Beach 14" S58°W 71ks(4.62')
#2 Beech 14" S45°E 441ks(29.04')

1874, Peter Eastman, M. C. Surv.
Found Old Post, no new witnesses

1966, Ken B. Stephens, M. C. Surv.
1" Iron Pipe

#3 Fence Post S05°E 36.74'
#4 W. Oak 10" East 20.69'

#5 Tw. Red Pine 10" & 14"
N80°W 27.76'

1974, John R. Radcliffe, #11368

- Found 5" sq. Conc. Monument
- #6 W. Pine 18" S02°E 11.93'
- #7 W. Pine 27" N38°E 64.64'
- #8 Tw. R. Pine N39°W 31.09'
- 1983, Lawrence Slater, # 7439
- Found 5" sq. Conc. Monument w/
- #13584, stamped in brass disc.
- #9 Oak 12" North 21.91'
- #10 Oak 13" East 20.88'
- #11 R. Pine 15" South 11.68'
- #12 R. Pine 23" N75°W 27.68'

B. Description of corner evidence found and/or method applied in restoring or reestablishing corner:

K-01 Section Corner for Sections 1 and 2, on the County Line, T20N, R17W.

On July 26, I found 5" square Concrete Monument with brass cap stamped RLS # 13854, Robert A. Griffin, 1971, 18" above ground, 18 feet North of center line of gravel road, with Pine Post 1.7 feet West, I found no evidence to dispute this location for the corner.

Condition of recorded witnesses are;

#1 Gone
#2 Gone

#3 Found in fair to poor condition

#11 Same as 6

#12 Same as 5

#4 Found in good condition

#5 Found in good condition

#6 Gone

#7 Gone

#8 Found good condition

#9 Found in good condition

#10 Same as 4

C. Description of monument for corner and accessories established to perpetuate locating the position of the corner:

K-01 Section Corner for Sections 1 and 2, on the County Line, T20N, R17W.

I accepted the 5" square concrete monument as a substantial marker for the corner, and is accepted as a careful and faithful reestablishment of the position of the original corner.

(ext. BT #4) White Oak 15" East 20.90'(16p nail w/ shiner on the South side of tree)


(ext. BT #8) White Pine 20" N 33° W 31.00' (60d spike in North side of tree)

(ext. BT #9) White Oak 16" N 02° W 21.88'(16p nail w/ shiner in East side of tree)

White Oak 18" S 30° W 50.25'(60d spike in SE side of tree)

Signed by Sammy S. Barnett
Surveyor's Michigan License No. 16923

Date 9-28-96

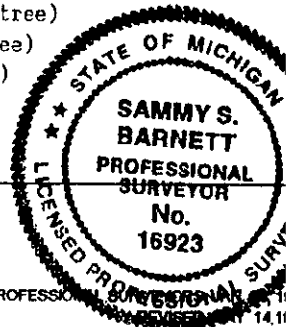

Peer Group Reviewed and Approved
Date: 9-30-96
Kenneth L. Ross
Mason County Surveyor

FORM APPROVED BY MICHIGAN STATE BOARD OF PROFESSIONAL SURVEYORS
REVISED JAN. 11
REVISED OCT. 11

LIBER

4 PAGE

44