


SURVEY & REMONUMENTATION

LAND CORNER RECORDATION CERTIFICATE
Filing Requirement of Act 74, Mich. P.A. 1970

OCT 29 1996

For corners in
MASON COMMISSION
(County)

Located In:	Corner Code #
1. Public Land Survey	T 20N R 17W K-2
	T R
	T R
	T R
2. Property Controlling in Section	S T R
	S T R
3. Miscellaneous Property in Sec.	S T R
	S T R

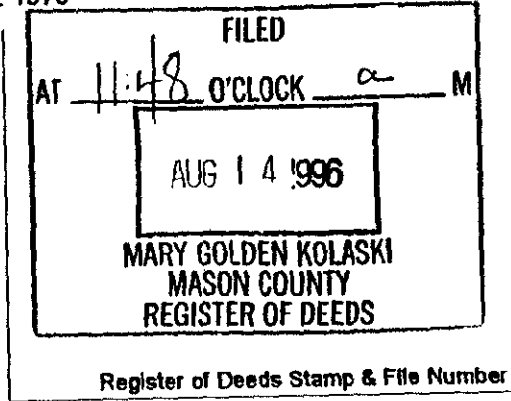

4. Lot No. _____, Recorded Plat _____
5. Private Claims _____

I, Sammy S. Barnett, in a field survey on July 31, 1996 do hereby state that under requirements of P.A. 74, Michigan P.A. of 1970, the corner points mentioned in lines 1 and 2 above were in conformance with regulations and rules therefore as required in the current manual of survey instructions of the United States Department of the Interior, Bureau of Land Management or by a decree of a Court of Law and /or that the corner points mentioned in lines 3, 4 and 5 above were in conformance with the rules of the Michigan Board of Land Surveyors or by a Decree of a Court of Law; established, re-established, monumented, recovered, found as expressed below:

A	B	C	D	E	F	G	H	I	J	K	L	M
1												
2	6	5	4	3	2							
3												
4	7	8	9	10	11	12						
5												
6	10	17	16	15	14	13						
7												
8	19	20	21	22	23	24						
9												
10	30	29	28	27	26	25						
11												
12	31	32	33	34	35	36						
13												

NOTE: Not more than 2 corners, all in the same town and range, may be recorded on this certificate.

A. Description of original monument and accessories and/or subsequent restoration:

- K-2 1/4 Corner for Section 1 and 2, T20N, R17W.
- 1839, John Brink, G.L.O. #4 Stop Sign S72°W 39.41'
 - Set Wood Post #5 Tele-pole S14°W 120.85'
 - #1 Beech 8" N45°W 201ks.(13.20')
 - #2 Beech 6" S32°E 171ks.(11/22')
 - 1966, K.B. Stephens, CO. Surv. #6 Stop Sign S65°W 48.75'
 - P.K. Nail in conc. Road #7 Tele-pole N45°W 39.45'
 - #3 Tele-pole N44°W 49.14' #8 Fence Post East 50.00'

- 1974, J. R. Ratcliffe, #11368 Replaced P.K. nail w/ 1/2" Iron
- #9 Power Pole N48°W 48.81'
- #10 East Post of Quade sign N81°W 34.70'
- #11 NE cor. garage S54°W 130.36'
- 1983, L. Slater, M.D.O.T. #7439 Found 3/8" Re-rod
- #12 Locast 3" N20°E 66.17'
- #13 East post Quade sign N80°W 44.86'
- #14 Iron Pipe 1" N40°W 49.32'
- #15 Poplar 6" N35°W 78.25'

B. Description of corner evidence found and/or method applied in restoring or reestablishing corner:

K-2 1/4 corner for Section 1 and 2, T20N, R17W.

On July 31, I found a 3/8" Re-rod in center of LaSalle Road, whice is concrete surface, I found no evidence to dispute this location for the corner.

Condition of recorded witnesses are;

- | | | | |
|-------------------|---------------|-----------------------------|-----------------------------|
| #1 Gone | #5 Gone | #9 Same as 3 | #13 Same as 10 |
| #2 Gone | #6 Gone | #10 Found in fair condition | #14 Found in good condition |
| #3 Gone | #7 Gone | #11 Found in good condition | #15 Found in good condition |
| #4 Found @ 40.61' | #8 Found down | #12 Found in good condition | |

C. Description of monument for corner and accessories established to perpetuate locating the position of the corner:


K-2 1/4 Corner for Section 1 and 2, T20N, R17W.

I replaced 3/8" Re-rod, in the exact location, with a 5/8" x 12" Re-rod, I drill a hole in concrete road, then chip concrete to place 3" aluminum cap, Stamped Mason County Monument, flush with road surface, and is accepted as a careful and faithful reestablishment of the position of the original corner.

- (ext BT #12) Black Locast 6" N 20° E 66.20'(16p nail w/ shiner NW side of tree)
- (ext BT #14) Iron pipe 1 1/2" N 40° W 49.32'
- (ext BT #15) Poplar 8" N 35° W 78.25'(16p nail w/ shiner SW side of tree)
- Tri. W. Cherry 6" 8" 11" S 82° W 94.60'(60d spike in North side of tree)

Signed by Sammy S. Barnett
Surveyor's Michigan License No. 16923

Date 8-12-96

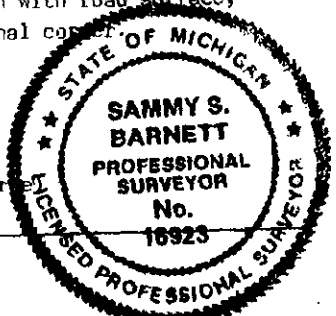

Peer Group Reviewed and Approved
Date: 8-13-96
Kenneth L. Ross
Mason County Surveyor

FORM APPROVED BY MICHIGAN STATE BOARD OF PROFESSIONAL SURVEYORS, JAN. 28, 1971
REVISED MAY 14, 1975
REVISED JAN., 1983
REVISED OCT., 1995