

SURVEY & REMONUMENTATION

OCT 29 1996

LAND CORNER RECORDATION CERTIFICATE
Filing Requirement of Act 74, Mich. P.A. 1970


For corners in **COMMISSION**

MASON (County) Located In: Corner Code #

1. Public Land Survey T 20N R 17W K-4
 T _____ R _____
 T _____ R _____
 T _____ R _____

2. Property Controlling in Section S _____ T _____ R _____
 S _____ T _____ R _____

3. Miscellaneous Property in Sec. S _____ T _____ R _____
 S _____ T _____ R _____

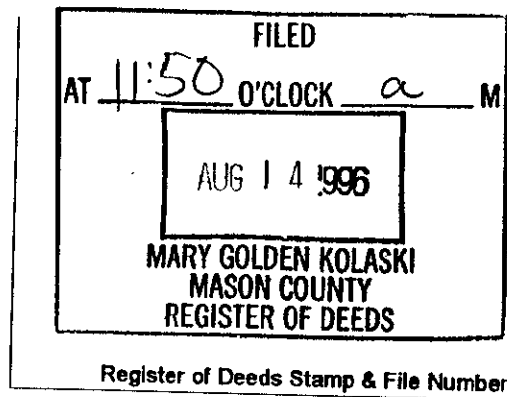

4. Lot No. _____, Recorded Plat _____
 5. Private Claims _____

I, Sammy S. Barnett, in a field survey on July 31, 1996 do hereby state that under requirements of P.A. 74, Michigan P.A. of 1970, the corner points mentioned in lines 1 and 2 above were in conformance with regulations and rules therefore as required in the current manual of survey instructions of the United States Department of the Interior, Bureau of Land Management or by a decree of a Court of Law and/or that the corner points mentioned in lines 3, 4 and 5 above were in conformance with the rules of the Michigan Board of Land Surveyors or by a Decree of a Court of Law; established, re-established, monumented, recovered, found as expressed below:

NOTE: Not more than 2 corners, all in the same town and range, may be recorded on this certificate.

| A | B | C | D | E | F | G | H | I | J | K | L | M |
|----|----|----|----|----|----|----|---|---|---|---|---|---|
| 1 | | | | | | | | | | | | |
| 2 | 6 | 5 | 4 | 3 | 2 | | | | | | | |
| 3 | | | | | | | | | | | | |
| 4 | 7 | 8 | 9 | 10 | 11 | 12 | | | | | | |
| 5 | | | | | | | | | | | | |
| 6 | 18 | 17 | 16 | 15 | 14 | 13 | | | | | | |
| 7 | | | | | | | | | | | | |
| 8 | 19 | 20 | 21 | 22 | 23 | 24 | | | | | | |
| 9 | | | | | | | | | | | | |
| 10 | 30 | 29 | 28 | 27 | 26 | 25 | | | | | | |
| 11 | | | | | | | | | | | | |
| 12 | 31 | 32 | 33 | 34 | 35 | 36 | | | | | | |
| 13 | | | | | | | | | | | | |

A. Description of original monument and accessories and/or subsequent restoration:

- K-4 1/4 Corner for Sections 11 and 12, T20N, R17W.
- 1839, John Brink, G.L.O. #4 Fence post N56°W 24.54'
 - Set Wood Post #5 Fence post S75°W 23.09'
 - #1 Tamarack 9" N70°W 211ks.(13.06')
 - #2 Spruce 8" N14°E 181ks.(11.89')
 - 1969, J. Borsfay, M.C.R.C. Found 1" Iron Pipe
 - #6 Fence cor. post East 25.50'
 - #7 Fence post West 23.40'
 - #8 Fence post NW 24.45'
 - 1966, K. B. Stephens, CO. Surv. 2" Iron pipe
 - #9 fence post S58°E 37.57'
 - #10 fence post S15°E 107.14'
 - #11 Jack pine 5" 42.54'

B. Description of corner evidence found and/or method applied in restoring or reestablishing corner:

K-4 1/4 Corner for Sections 11 and 12, T20N, R17W.

On July 31, I found a 1" Iron Pipe, 2 feet East of the center-line of LaSalle Road (broken asphalt surface), I found no evidence to dispute this location for the corner.

Condition of recorded witnesses are;

- #1 Gone #6 Same as 3 #10 Found in poor condition
- #2 Gone #7 Same as 5 #11 did not find (no bearing given)
- #3 Gone #8 Same as 4
- #4 Gone #9 Found in good condition
- #5 Gone

C. Description of monument for corner and accessories established to perpetuate locating the position of the corner:

- K-4 1/4 Corner for Section 11 and 12, T20N, R17W.
- I set a Standard Mason County Monument inside the existing 1" Iron Pipe, I set aluminum cap flush with the road surface, do to the fact that asphalt is badly broken, I did not set a road monument box. Corner is accepted as a careful and faithful reestablishment of position of the original corner.
- (ext #9) Fence Post 6" x 8" S 50° E 37.68'(60d spike in SW side of post)
 - Jack Pine 7" N 30° E 71.01'(60d spike in SE side of tree)
 - Jack Pine 5" S 54° W 43.25'(60d spike in SE side of tree)
 - Jack Pine 4" N 50° W 45.30'(60d spike in NE side of tree)

Signed by Sammy S. Barnett
 Surveyor's Michigan License No. 16923

Date 8-12-96



Peer Group Reviewed and Approved
 Date: 8-12-96
Kenneth L. Ross
 Mason County Surveyor