

SURVEY & REMONUMENTATION


OCT 29 1996

COMMISSION

LAND CORNER RECORDATION CERTIFICATE Filing Requirement of Act 74, Mich. P.A. 1970

For corners in

<u>MASON</u> <small>(County)</small>	Located in:	Corner Code #
1. Public Land Survey	T <u>20N</u> R <u>17W</u>	<u>K-5</u>
	T _____ R _____	_____
	T _____ R _____	_____
	T _____ R _____	_____
2. Property Controlling in Section	S _____ T _____ R _____	_____
	S _____ T _____ R _____	_____
3. Miscellaneous Property in Sec.	S _____ T _____ R _____	_____
	S _____ T _____ R _____	_____

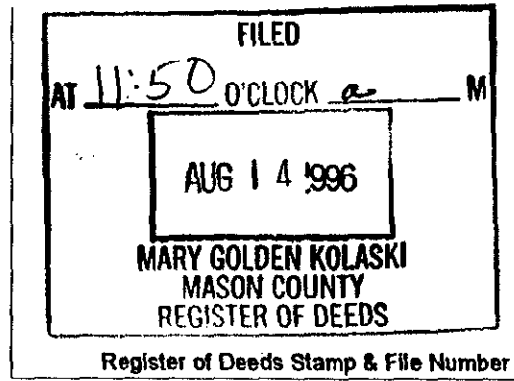

4. Lot No. _____, Recorded Plat _____
5. Private Claims _____

I, Sammy S. Barnett, in a field survey on July 31, 1996 do hereby state that under requirements of P.A. 74, Michigan P.A. of 1970, the corner points mentioned in lines 1 and 2 above were in conformance with regulations and rules therefore as required in the current manual of survey instructions of the United States Department of the Interior, Bureau of Land Management or by a decree of a Court of Law and /or that the corner points mentioned in lines 3, 4 and 5 above were in conformance with the rules of the Michigan Board of Land Surveyors or by a Decree of a Court of Law; established, re-established, monumented, recovered, found as expressed below:

NOTE: Not more than 2 corners, all in the same town and range, may be recorded on this certificate.

	A	B	C	D	E	F	G	H	I	J	K	L	M
1													
2	6		5		4		3		2		1		
3													
4	7		8		9		10		11		12		
5													
6	18		17		16		15		14		13		
7													
8	19		20		21		22		23		24		
9													
10	30		29		28		27		26		25		
11													
12	31		32		33		34		35		36		
13													

A. Description of original monument and accessories and/or subsequent restoration:

- K-5 Section Corner for Sections 11, 12, 13 and 14.
- | | | |
|---------------------------------------|-----------------------------------|--------------------------------|
| <u>1839, John Brink, G.L.O.</u> | #4 Power Pole N67°W 35.28' | 1980, H.L. Fluharty, #18223 |
| Set Wood Post | #5 Maple clump 5" S45°W 48.35' | Found 5/8" Iron w/cap |
| #1 Tamarack 10" S50°E 261ks.(17.16') | | #6 power Pole N69°W 35.19' |
| #2 Tamarack 10" N40°W 231ks.(15.18') | <u>1969, J. Borsfay, M.C.R.C.</u> | #7 Birch clump 8" S65°W 69.06' |
| <u>1966, K.B. Stephens, CO. Surv.</u> | Found 2" Iron Pipe | #8 Fence Post N67°E 38.82' |
| 2" Iron Pipe | | |
| #3 Fence corner N63°E 38.59' | | |

B. Description of corner evidence found and/or method applied in restoring or reestablishing corner:

- K-5 Section Corner for Sections 11, 12, 13 and 14.
- ON July 31, I found a 5/8" Re-rod with a RLS Cap (can't read), also found 2" Iron pipe below re-rod, Found at the intersection of LaSalle and Koenig Roads (both gravel). I found no evidence to dispute this location for the corner.
- Condition of recorded witnesses are;
- | | |
|----------------------------|----------------|
| #1 Gone | #5 Gone |
| #2 Gone | #6 Same as 4 |
| #3 Gone | #7 Found stump |
| #4 Found in good condition | #8 Gone |

C. Description of monument for corner and accessories established to perpetuate locating the position of the corner:

- K-5 Section Corner for Sections 11, 12, 13 and 14.
- I replaced found Irons, in the exact location, with a Standard Mason County Monument, set 1.0 foot below gravel road, and is accepted as a careful and faithful reestablishment of the position of the original corner.
- (ext BP #4) Power Pole N 65° W 35.21'(60d spike in SW side of pole)
 (ext BT) Jack Pine 14" S 57° W 57.34'(60d spike in NW side of tree)
 (ext BT) Jack Pine 6" N 50° E 43.44'(60d spike in NW side of tree)
 Jack Pine 6" S 49° E 51.51 (60d spike in NE side of tree)

Signed by Sammy S. Barnett
 Surveyor's Michigan License No. 16923

Date 8-12-96



Peer Group Reviewed and Approved
 Date: 8-23-96
Kenneth L. Ross
 Mason County Surveyor