

SURVEY & REMONUMENTATION


MAY 07 1997

COMMISSION

LAND CORNER RECORDATION CERTIFICATE
Filing Requirement of Act 74, Mich. P.A. 1970

For corners in

Mason (County)	Located In:	Corner Code #
1. Public Land Survey	T 20N R 17W	K-07
	T R	
	T R	
	T R	
2. Property Controlling in Section	S T R	
	S T R	
3. Miscellaneous Property in Sec.	S T R	
	S T R	

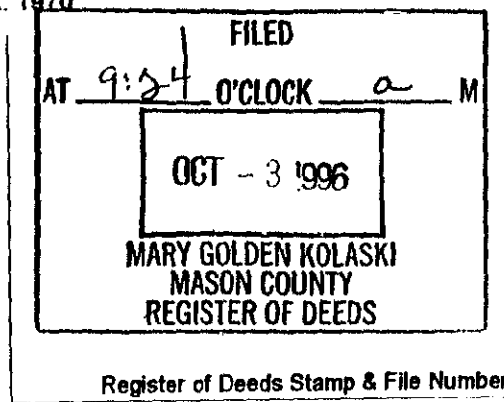

4. Lot No. _____, Recorded Plat _____
5. Private Claims _____

I, Sammy S. Barnett, in a field survey on Sept, 1996 do hereby state that under requirements of P.A. 74, Michigan P.A. of 1970, the corner points mentioned in lines 1 and 2 above were in conformance with regulations and rules therefore as required in the current manual of survey instructions of the United States Department of the Interior, Bureau of Land Management or by a decree of a Court of Law and/or that the corner points mentioned in lines 3, 4 and 5 above were in conformance with the rules of the Michigan Board of Land Surveyors or by a Decree of a Court of Law, established, re-established, monumented, recovered, found as expressed below:

	A	B	C	D	E	F	G	H	I	J	K	L
1												
2	6	5	4	3	2	1						
3												
4	7	8	9	10	11	12						
5												
6	18	17	16	15	14	13						
7												
8	19	20	21	22	23	24						
9												
10	30	29	28	27	26	25						
11												
12	31	32	33	34	35	36						
13												

NOTE: Not more than 2 corners, all in the same town and range, may be recorded on this certificate.

A. Description of original monument and accessories and/or subsequent restoration:

- K-07 Corner common to sections 13, 14, 23 & 24, T20N, R17W (Grant) 1839 John Brink G.L.O.
- #1 Beech 9" S09E 41 lks. (27.06')
- #2 Beech 11" N46W 18 lks. (11.88') 1966 K.B. Stephens
- Found 1 1/2" Pipe
- #3 J. Pine 8" N48W 46.94'
- #4 J. Pine 5" N57E 50.62'
- #5 J. Pine 5" S34E 45.52'
- #6 Maple 7" N88W 40.14'
- 1971 J. Borsfay found 1 1/2" pipe
- #7 J. Pine 9" N48W 46.95' (#3)
- #8 J. Pine 6" N57E 50.62' (#4)
- #9 Maple 8" N88W 40.20' (#6)
- 1965 T.J. Vaillencourt
- Found 1" pipe No witnesses given

- 1974 H. Fluharty Act 132 L. 1 P. 410
- Found 1" pipe at intersection of roads
- #10 J. Pine 16" S42W 36.80'
- #11 Power pole S40E 50.55'
- #12 J. Pine 10" N53W 47.03' (#3 & 7)
- 1990 K. Ross
- Found 1" pipe
- No witnesses given

B. Description of corner evidence found and/or method applied in restoring or reestablishing corner:

K-07 Corner common to sections 13, 14, 23 & 24, T20N, R17W (Grant)
On Sept. 5, I found a 1" bent iron pipe at surface of roads N-S and East. I found no evidence to dispute this location.

Condition of recorded witnesses are:

- #1 Gone
- #2 Gone
- #3 Found J. Pine 12" N47W 47.06' spike in NE side
- #4 Gone
- #5 Gone
- #6 Found Maple 11" N88W 40.14' spike in S. side
- #7 Gone
- #8 Gone
- #9 Gone
- #10 Gone
- #11 Found Power pole S35E 50.58' spike in SW side
- #12 Gone


C. Description of monument for corner and accessories established to perpetuate locating the position of the corner:

K-07 Corner common to sections 13, 14, 23 & 24, T20N, R17W (Grant)
I replaced the bent 1" iron pipe, in the exact location, with a Standard Mason County Monument, 0.4' below the surface of the road, and is accepted as a careful and faithful reestablishment of the position of the original corner.

- #3 J. Pine 12" N47W 47.06' spike in NE side
- #6 Maple 11" N88W 40.14' spike in S. side.
- #11 Power pole S35E 50.58' spike in SW side
- #12 Power pole S30W 48.00' spike in NW side

Signed by Sammy S. Barnett
Surveyor's Michigan License No. 16923

Date 9-27-96

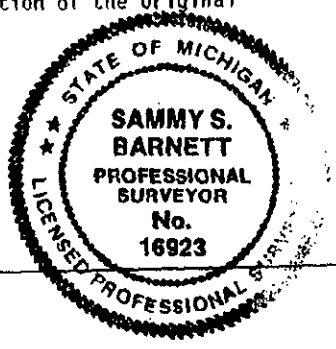

Peer Group Reviewed and Approved
Date: 9-30-96
Robert L. Ross
Mason County Surveyor