

**SURVEY &
REMONUMENTATION**


MAY 07 1997

COMMISSION

**LAND CORNER RECORDATION CERTIFICATE
Filing Requirement of Act 74, Mich. P.A. 1970**

For corners in

Mason (County)	Located In:	Corner Code #
1. Public Land Survey	T20N R 17W	K-08
	T R	
	T R	
	T R	
2. Property Controlling in Section	S T R	
	S T R	
3. Miscellaneous Property in Sec.	S T R	
	S T R	

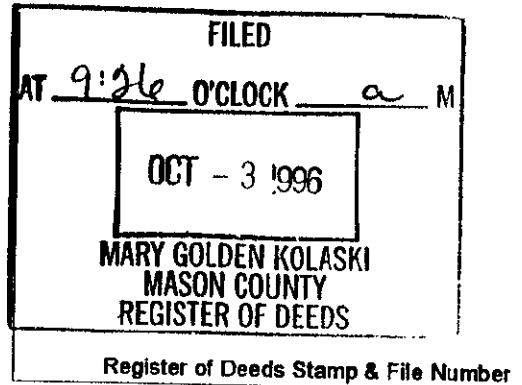

4. Lot No. _____, Recorded Plat _____
5. Private Claims _____

I, Sammy S. Barnett, in a field survey on Sept, 1996 do hereby state that under requirements of P.A. 74, Michigan P.A. of 1970, the corner points mentioned in lines 1 and 2 above were in conformance with regulations and rules therefore as required in the current manual of survey instructions of the United States Department of the Interior, Bureau of Land Management or by a decree of a Court of Law and /or that the corner points mentioned in lines 3, 4 and 5 above were in conformance with the rules of the Michigan Board of Land Surveyors or by a Decree of a Court of Law; established, re-established, monumented, recovered, found as expressed below:

NOTE: Not more than 2 corners, all in the same town and range, may be recorded on this certificate.

	A	B	C	D	E	F	G	H	I	J	K	L
1												
2	6		5		4		3		2		1	
3												
4	7		8		9		10		11		12	
5												
6	10		17		16		15		14		13	
7												
8	19		20		21		22		23		24	
9												
10	30		29		28		27		26		25	
11												
12	31		32		33		34		35		36	
13												

A. Description of original monument and accessories and/or subsequent restoration:

- K-08 Corner common to sections 23 & 24. T20N. R17W (Grant)
- 1839 John Brink G.L.O.
- Set post
- #1 Beech 10" S25E 20 lks. (13.2')
- #2 Beech 8" S49W 36 lks (23.76')
- 1966 K.B. Stephens found 1" pipe
- #3 R. Oak 10" S18E 79.88'
- #4 Pine 12" N52W 37.00'
- #5 Maple 30" S85W 73.83'
- 1971 J. Borsfey M.C.R.C.
- Found 1" pipe
- #6 Pine 13" N52W 37.01' (# 4)
- #7 Maple 31" S85W 73.83' (# 5)
- 1974 H. Fluharty Act 132 L. 1 P. 279
- & L. 1 P. 410 found pipe C/L road under power lines
- #8 R. Pine 16" N28W 76.60'
- #9 R. Pine 18" N64W 37.00' (# 4)
- #10 Maple 38" S82W 73.85' (# 5 & 7)
- 1990 K. Ross
- Found pipe
- No witnesses

B. Description of corner evidence found and/or method applied in restoring or reestablishing corner:


- K-08 Corner common to sections 23 & 24 T20N. R17W (Grant)
- On Sept. 5, I found 1/2" re-bar inside 1" pipe 36" long 0.5" below road surface in centerline of N-S gravel road. I found no evidence to dispute this location. Condition of recorded witnesses are:
- #1 Gone
- #2 Gone
- #3 Gone
- #4 Pine 16" N57W 37.07' spike in NE side
- #5 Maple 34" S85W 73.85' spike in S. side
- #6 same as #4
- #7 Same as # 5
- #8 Found no spike
- #9 Same as #4
- #10 Same as # 5 & 7

C. Description of monument for corner and accessories established to perpetuate locating the position of the corner:

- K-08 Corner common to sections 23 & 24 T20N. R17W (Grant)
- I replaced 1/2" re-bar & 1" pipe. in the exact location. with a Standard Mason County Monument. 0.5' below the road surface. and accepted this location as a careful and faithful reestablishment of the position of the original corner.
- #4 Pine 16" N57W 37.07' spike in NE side
- #5 Maple 34" S85W 73.85' spike in S. side
- #11 Ext. B.T. Red Pine 18" N32W 59.10' spike in NE side
- #12 Red Pine 16" N82W 42.21' spike in S. side

Signed by Sammy S. Barnett
Surveyor's Michigan License No. 16923

Date 9-27-96

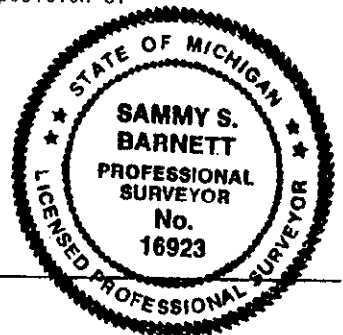

Peer Group Reviewed
and Approved
Date: 9-30-96
Kenneth L. Ross
Mason County Surveyor