


DEC 29 1998

SECTION

LAND CORNER RECORDATION CERTIFICATE
Filing Requirement of Act 74, Mich. P.A. 1970

Form with fields: For corners in Mason (County), Located In, Corner Code #, 1. Public Land Survey, 2. Property Controlling in Section, 3. Miscellaneous, 4. Lot No., 5. Private Claims

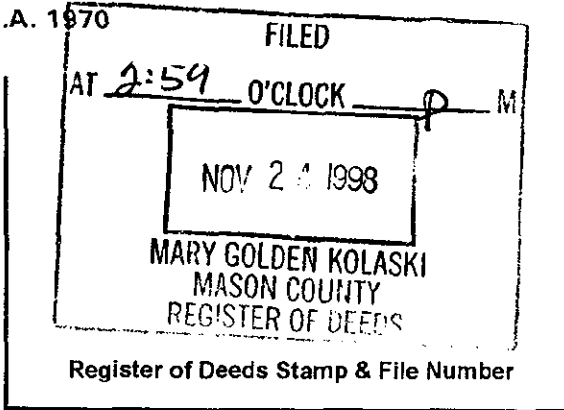

Grid table with columns A-M and rows 1-13, containing numbers 1-36

I, Kenneth L. Ross, in a field survey on October 10, 1998, do hereby certify that under requirements of P.A. 74, Michigan P.A. of 1970, the corner points mentioned in lines 1 and 2 above were in conformance with regulations and rules therefore as required in the current manual of survey instructions of the United States Department of the Interior, Bureau of Land Management or by a decree of a Court of Law and/or that the corner points mentioned in lines 3, 4 and 5 above were in conformance with the rules of the Michigan Board of Land Surveyors or by a Decree of a Court of Law; established, re-established, monumented, re-monumented, recovered, found as expressed below:

NOTE: Not more than 4 corners, all in the same town and range, may be recorded on this certificate.

A. Description of original monument and accessories and/or subsequent restoration: K-13 Corner Common to Sections 35 and 36, T.20N., R.17W.,

ORIGINAL GOVERNMENT SURVEY Mullett and Brookfield, 1837 to 1838 Set Post (1) Beech 10", N83°W, 27 links (17.82') (2) Hemlock, 7", N56°E, 38 links (25.08') K-1, T.19N., R.17W., East 13.2 feet KENNETH B. STEPHENS, 1968, Dwg. H-144 No Witnesses Given Shows tie to this Corner from the NW Corner of Sec. 2, T.19N., R. 17W., of 13.25' East. MASON COUNTY ROAD COMMISSION, UNDATED State Kenneth B. Stephens, 1966 1" pipe 1" below surface (3) P.P. S23°E, 79.36' (4) Maple, 36", S45°W, 39.20' (5) Maple, 24", S71°W, 96.49' In 1973 J. Borsfay found this iron and witnesses (3) thru (5)

KENNETH L. ROSS, PLS Tied this corner in several surveys, 1977 (File H-246) 1996, (File 96204S) No witnesses given Corner K-1, T.19N., R.17W., East 13.25'


B. Description of corner evidence found and/or method applied in restoring or reestablishing corner: K-13 Corner Common to Sections 35 and 36, T.20N., R.17W.,

On October 10, 1998, I found a 1" X 18" Pipe, 6" below the road surface. I found no other evidence to dispute this location for this corner.

Condition of Record Witnesses are as follows: (1) Gone, (2) Gone, (3) Found in good condition, (4) Gone, (5) Gone, Corner K-1, T.20N., R.17W., East 13.25 feet.

C. Description of monument for corner and accessories established to perpetuate locating the position of the corner: K-13 Corner Common to Sections 35 and 36, T.20N., R.17W.,

I removed the 1" X 18" Pipe and placed a 4" X 20" Harrison cast iron Monument, stamped "Mason County Monument" in the exact location of this corner. This corner is accepted as a careful and faithful re-establishment of the original corner. Ext. "BT" (3) P.P. S 23°E, 79.31 feet, (60d spike SW Side) (6) 8" White Pine, N 36°E, 58.70', (60d Spike NW Side) (7) Fence Cor Post, S 45°E, 49.74 feet, (60d spike SW Side) (8) 40" Maple, S 41°W, 43.15 feet, 60d spike SE side) Corner K-1, East 13.25 feet

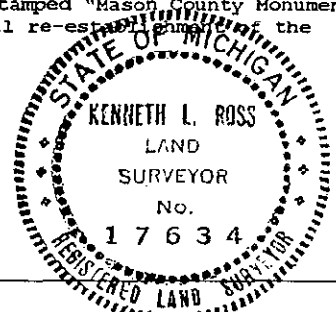

Signed by [Signature] Date 11-19-98

Surveyor's Michigan License No. 17634

Approved by Peer Review Group On [Signature] 11-19-98 Kenneth L. Ross, County Representative

FORM APPROVED BY MICHIGAN STATE BOARD OF LAND SURVEYORS, JAN. 28, 1971 REVISED MAY 14, 1975 REVISED JAN., 1983 ADAPTED FOR WORD PROCESSING MARCH, 1993