

SURVEY & REMONUMENTATION


MAY 07 1997

COMMISSION

LAND CORNER RECORDATION CERTIFICATE
Filing Requirement of Act 74, Mich. P.A. 1970

For corners in

<u>MASON</u> (County)	Located In:	Corner Code #
1. Public Land Survey	T20N R17W	M-02
	T R	
	T R	
	T R	
2. Property Controlling in Section	S T R	
	S T R	
3. Miscellaneous Property in Sec.	S T R	
	S T R	

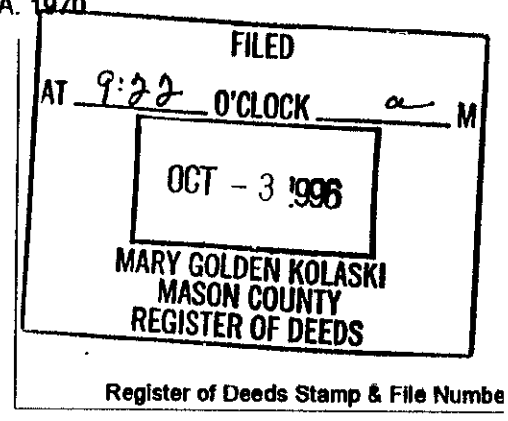

4. Lot No. _____, Recorded Plat _____
5. Private Claims _____

I, Sammy S. Barnett, in a field survey on July 26, 1996 do hereby state that under requirements of P.A. 74, Michigan P.A. of 1970, the corner points mentioned in lines 1 and 2 above were in conformance with regulations and rules therefore as required in the current manual of survey instructions of the United States Department of the Interior, Bureau of Land Management or by a decree of a Court of Law and/or that the corner points mentioned in lines 3, 4 and 5 above were in conformance with the rules of the Michigan Board of Land Surveyors or by a Decree of a Court of Law; established, re-established, monumented, recovered, found as expressed below:

NOTE: Not more than 2 corners, all in the same town and range, may be recorded on this certificate.

A	B	C	D	E	F	G	H	I	J	K	L
	6	5		4		3		2			
	7	8		9		10		11			
	18	17		16		15		14			
	19	20		21		22		23			
	30	29		28		27		26			
	31	32		33		34		35			

A. Description of original monument and accessories and/or subsequent restoration:

- M-02 1/4 Corner for Section 1, on the Township Line, T20N, R17W.
- | | | |
|---|-------------------------------------|------------------------------------|
| <u>1837, Mullett and Brookfield, G.L.O.</u> | #4 R. Oak 24" N30°E 90.26' | <u>1983, Lawrence Slater, #74.</u> |
| Set Wood Post | #5 Maple 20" S20°E 139.81' | Found 5" Conc. Monu. by Gr: |
| #1 Hemlock 10" S 07° W 271ks.(17.82') | <u>1974, John Radcliffe, #11368</u> | #9 Oak 26" N30°E 90.35' |
| #2 Maple 10" N 28° W 671ks.(44.22') | Found 1" Iron Pipe in road | #10 W. Cherry 5" S55°E 64 |
| <u>1974, Ken Ross, #17634</u> | #6 Cor. fence post N89°W 31.82' | #11 W. Cherry 5" S40°E 31 |
| Found 1 1/2" Iron pipe | #7 Oak 4" N41°W 43.00' | #12 Cor. fence post N55°W : |
| #3 Cor. fence post N75°W 38.75' | #8 Oak no size N30°E 73.60' | |

B. Description of corner evidence found and/or method applied in restoring or reestablishing corner:

M-02 1/4 Corner for Section 1, on the Township Line, T20N, R17W.

On July 26, 1996, I found a 5" square Concrete Monument 0.8' below the center of Budde Road, monument with a 3" brass disc, stamped RLS #13834, 1982(Robert Griffin), also found sign on pine post S 88° W, 33.00' I found no evidence to dispute this location for the corner.

Condition of recorded witnesses are;

#1 Gone	#5 Gone	#9 Same as 4	#12 Same as 3
#2 Gone	#6 Same as 3	#10 Found in good condition	
#3 Found down	#7 Gone	#11 Found in good condition	
#4 Found in good condition	#8 Same as 4		

C. Description of monument for corner and accessories established to perpetuate locating the position of the corner:


M-02 1/4 Corner for Section 1, on the Township Line, T20N, R17W.

I accepted the existing 5" square Concrete Monument with brass disc. as a substantial marker for the corner and is accepted as a careful and faithful reestablishment of the position of the Original corner.

(ext. BT #4) Black Oak 28" N27°E 90.35'(10" dock spike in NW side of tree)
 (ext. BT #10) W. Cherry 8" S 55° E 64.33'(60d spike in NE side of tree)
 (ext. BT) Black Oak 14" S 77° E 126.72'(10" dock spike in NE side of tree, also has tree)
 Red Pine 4" N 72° W 39.90'(60d spike in NE side of tree)

Signed by Sammy S. Barnett
Surveyor's Michigan License No. 16923

Date 9-28-96

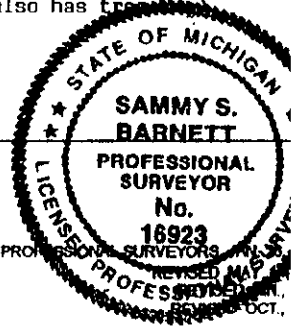

Peer Group Reviewed and Approved
Date: 9-30-96
Kenneth L. Fosy
Mason County Surveyor

FORM APPROVED BY MICHIGAN STATE BOARD OF PROFESSIONAL SURVEYORS