

**SURVEY &
REMONUMENTATION**

DEC 18 1995


COMMISSION

LAND CORNER RECORDATION CERTIFICATE

Filing Requirement of Act 74, Mich. P.A. 1970

For corners in

MASON	County	Located In	Corner Code //
1	Public Land Survey	T 20N R 17W	H-3
		T R	
		T R	
		T R	
2	Property Controlling in Section	S T R	
		S T R	
3	Miscellaneous Property in Sec.	S T R	
		S T R	
4	Lot No. , Recorded Plat		
5	Private Claims		

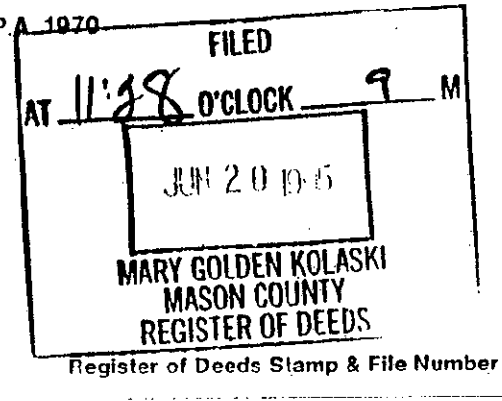

I, **Kenneth L. Ross**, in a field survey on **MAY 05**, 19**95**, do hereby certify that under requirements of P.A. 74, Michigan P.A. of 1970, the corner points mentioned in lines 1 and 2 above were in conformance with regulations and rules therefore as required in the current manual of survey instructions of the United States Department of the Interior, Bureau of Land Management or by a decree of a Court of Law and/or that the corner points mentioned in lines 3, 4 and 5 above were in conformance with the rules of the Michigan Board of Land Surveyors or by a Decree of a Court of Law, established, re established, monumented, re monumented, recovered, found as expressed below

	A	B	C	D	E	F	G	H	I	J	K	L	M
2		6		5		4		3		2		1	
3													
4		7		8		9		10		11		12	
5													
6		18		17		16		15		14		13	
7													
8		19		20		21		22		23		24	
9													
10		30		29		28		27		26		25	
11													
12		31		32		33		34		35		36	
13													

NOTE: Not more than 4 corners, all in the same town and range, may be recorded on this certificate.

A Description of original monument and accessories and/or subsequent restoration.


H-3 Sec. Cor., 1 & 12-20-17; 6 & 7-20-16
1837 Hullett & Brookfield
(1) 16" Hemlock S 35 W 40 lks
(2) 16" Hemlock N 66 W 45 lks

B. Description of corner evidence found and/or method applied in restoring or reestablishing corner:

H-3 Sec. Cor., 1 & 12-20-17; 6 & 7-20-16
Feb., 1989, M.D.O.T. Fd. 60d nail in 1 1/4" Pipe in Mon. Box, 8.5' E CL US 31 (Job No. 26668) (filed Act 74 Liber 2, Page 193)
(3) N 40 E 62.20' Power Pole
(4) S 20 E 72.01' G. Post
(5) S 40 W 68.18' G. Post
Jul., 1969, Stephens used corner in survey
May, 1973, Weinert used corner in survey (Liber 1 R.C.S., Page 166)
May, 1973, Weinert used corner in survey (Liber 1 R.C.S., Page 161)
Jun., 1973, Slawinski Fd. Iron in mon. box (Liber 1 R.C.S., Page 227) (filed Act 74 Liber 1, Page 211)
(6) N 40 E 62.25' Power Pole
(7) S 30 E 72.10' Guard Post
Aug., 1973, Ross used corner in survey
Jun., 1974, Radcliffe Fd. 1" Pipe in mon. box (filed Act 74 Liber 1, Page 251)
(8) N 36 E 62.20' Power Pole
(9) S 28 E 72.12' Culvert Post
(10) S 32 W 68.20' Culvert Post
Jan., 1976, Barnett Fd. Iron in mon. box 8.6' E of CL US31 (Liber 1 R.C.S., Page 368)
Mar., 1976, Slawinski Fd. Iron pipe in mon. box (Liber 1 R.C.S., Page 421)
Witness same as 6 & 7 above (cont. on back)

C Description of monument for corner and accessories established to perpetuate locating the position of the corner

H-3 Sec. Cor., 1 & 12-20-17; 6 & 7-20-16
No witness from above found
Left existing 1 1/4" pipe in place, no 2 1/2" alum. cap set, replaced mon. box, 7.7' E of CL US31 and 1.0' N of CL Hoague Rd, and is accepted as the best available evidence of the original corner.
N 43 E 74.72' Power Pole
N 76 W 189.96' Tele. Box
S 54 W 86.77' Power Pole
S 33 W 183.46' 6" W. Pine

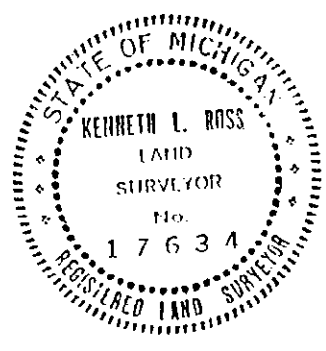

Peer Group Reviewed and Approved
Date: 6-14-95
Kenneth L. Ross
Mason County Surveyor

Signed by *Kenneth L. Ross*
Surveyor's Michigan License No. 17634

Date 6-14-95

Aug., 1977, Slawinski used corner in survey (Liber 1 R.C.S., Page 478)
Nov., 1986, Ross Fd. Iron in mon. box
Aug., 1988, Ross Fd. Iron in mon. box
Dec., 1989, Ross Fd. Iron in mon. box
Sep., 1990, Ross Fd. Iron in mon. box
Jul., 1993, Ross Fd. Iron in mon. box
Jul., 1993, Ross Fd. Iron in mon. box
May, 1995, Ross Ed. existing 1 1/4" pipe in remains of mon. box