

**SURVEY &  
REMONUMENTATION**


DEC 18 1995

**COMMISSION**

**LAND CORNER RECORDATION CERTIFICATE  
Filing Requirement of Act 74, Mich. P.A. 1970**

For corners in

<u>MASON</u> (County)	Located In:	Corner Code: #
1. Public Land Survey	T 20N R 17W	M-4
	T R	
	T R	
	T R	
2. Property Controlling in Section	S T R	
	S T R	
3. Miscellaneous Property in Sec.	S T R	
	S T R	
4. Lot No. _____, Recorded Plat _____		
5. Private Claims _____		

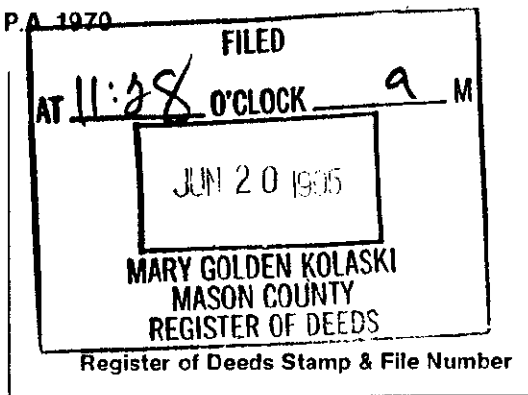

A	B	C	D	E	F	G	H	I	J	K	L	M
2	6	5	4	3	2	1						
3												
4	7	8	9	10	11	12						
5												
6	18	17	16	15	14	13						
7												
8	19	20	21	22	23	24						
9												
10	30	29	28	27	26	25						
11												
12	31	32	33	34	35	36						
13												

I, Kenneth L. Ross, in a field survey on MAY 05, 1995, do hereby certify that under requirements of P.A. 74, Michigan P.A. of 1970, the corner points mentioned in lines 1 and 2 above were in conformance with regulations and rules therefore as required in the current manual of survey instructions of the United States Department of the Interior, Bureau of Land Management or by a decree of a Court of Law and/or that the corner points mentioned in lines 3, 4 and 5 above were in conformance with the rules of the Michigan Board of Land Surveyors or by a Decree of a Court of Law; established, re-established, monumented, re-monumented, recovered, found as expressed below:

**NOTE: Not more than 4 corners, all in the same town and range, may be recorded on this certificate.**

**A. Description of original monument and accessories and/or subsequent restoration:**


M-4 1/4 Corner, 12-20-17 & 7-20-16  
1837 Hullett & Brookfield  
(1) 6" Maple S 28 W 23 lks  
(2) 12" W. Pine N 53 W 33 lks

**B. Description of corner evidence found and/or method applied in restoring or reestablishing corner:**

M-4 1/4 Corner, 12-20-17 & 7-20-16  
Nov., 1986, Ross located 1/16 line  
Dec., 1989, Ross computed location of corner

**C. Description of monument for corner and accessories established to perpetuate locating the position of the corner:**

M-4 1/4 Corner, 12-20-17 & 7-20-16  
No witness from above found  
Corner position established by single proportion measurement.  
Set 5/8" X 24" rebar with 2 1/2" alum. cap in mon. box, on CL US31, and is accepted as the best available evidence of the original corner.  
N 13 W 189.84' Power Pole  
S 28 W 109.26' Power Pole  
S 20 E 206.07' 12" W. Pine  
N 34 E 122.47' Power Pole

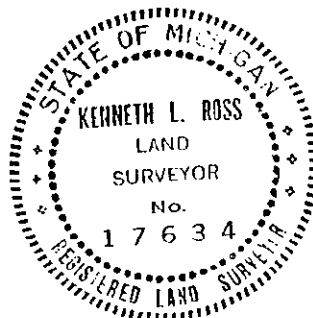

Peer Group Reviewed and Approved  
Date: 6-14-95  
Kenneth L. Ross  
Mason County Surveyor

Signed by [Signature] Date 6-14-95  
Surveyor's Michigan License No. 17634