

**SURVEY &  
REMONUMENTATION**


DEC 18 1995

**COMMISSION**

**LAND CORNER RECORDATION CERTIFICATE  
Filing Requirement of Act 74, Mich. P.A. 1970**

For corners in

<b>MASON</b> (County)	Located In:	Corner Code #/
1. Public Land Survey	T 20N R 17W	M-5
	T R	
	T R	
	T R	
2. Property Controlling in Section	S T R	
	S T R	
3. Miscellaneous Property in Sec.	S T R	
	S T R	
4. Lot No. _____	Recorded Plat _____	
5. Private Claims _____		

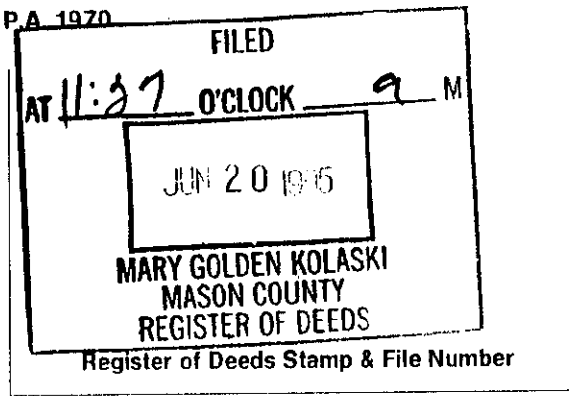

I, **Kenneth L. Ross**, in a field survey on **MAY 05**, 19 **95**, do hereby certify that under requirements of P.A. 74, Michigan P.A. of 1970, the corner points mentioned in lines 1 and 2 above were in conformance with regulations and rules therefore as required in the current manual of survey instructions of the United States Department of the Interior, Bureau of Land Management or by a decree of a Court of Law and/or that the corner points mentioned in lines 3, 4 and 5 above were in conformance with the rules of the Michigan Board of Land Surveyors or by a Decree of a Court of Law; established, re-established, monumented, re-monumented, recovered, found as expressed below:

A	B	C	D	E	F	G	H	I	J	K	L	M
2	6	5	4	3	2							
3												
4	7	8	9	10	11	12						
5												
6	18	17	16	15	14	13						
7												
8	19	20	21	22	23	24						
9												
10	30	29	28	27	26	25						
11												
12	31	32	33	34	35	36						
13												

**NOTE: Not more than 4 corners, all in the same town and range, may be recorded on this certificate.**

**A. Description of original monument and accessories and/or subsequent restoration:**


M-5 Sec. Cor., 12 & 13-20-17; 7 & 18-20-16  
1837 Mullett & Brookfield  
(1) 10" Hemlock S 31 W 34 lks  
(2) 10" Hemlock N 33 W 23 lks

**B. Description of corner evidence found and/or method applied in restoring or reestablishing corner:**

M-5 Sec. Cor., 12 & 13-20-17; 7 & 18-20-16 Feb., 1989, M.D.O.T. Fd. 3/4" Steel Pin in Mon. Box in CL US 31, 4' S CL two track W & CL Rd E (Job No. 26668)(filed Act 74 Liber 2, Page 194) (3) N 43 E 91.29' 5" W. Cherry (4) N 58 E 73.09' 10" Maple (5) S 05 E 48.56' Tele. Ser. Pole (6) N 25 W 20.23' 4" W. Birch Sep., 1966, Stephens Fd. 60d nail at surface of asphalt (7) N 71 E 40.16' NE Cor. NE Headwall (8) S 49 E 54.91' Guy Pole #460 (9) S 65 W 29.46' SE Cor. S Headwall for N-S Culv.	Oct., 1986, Ross Fd. Iron in mon. box Nov., 1986, Ross Fd. Iron in mon. box Aug., 1991, Ross used corner in survey Jan., 1993, Ross Fd. Iron in mon. box May, 1995, Ross Fd. corner destroyed by road reconstruction. Corner position restored by reconstruction of M.D.O.T. control survey using surrounding section corners.
--	--

**C. Description of monument for corner and accessories established to perpetuate locating the position of the corner:**

M-5 Sec. Cor., 12 & 13-20-17; 7 & 18-20-16  
No witness from above found  
Set 5/8" X 24" rebar with 2 1/2" alum. cap in mon. box, 0.4' W of CL US31 and 3.0' N of CL Koenig Rd, and is accepted as the best available evidence of the original corner.  
S 34 E 142.79' NW Cor. Garage  
N 71 E 82.82' Power Pole  
N 41 E 100.86' Chisel Cross Top of Conc. Headwall  
N 50 W 164.04' 16" W. Pine  
S 77 W 68.15' Chisel Cross Top of Conc. Headwall  
S 76 W 128.95' Power Pole

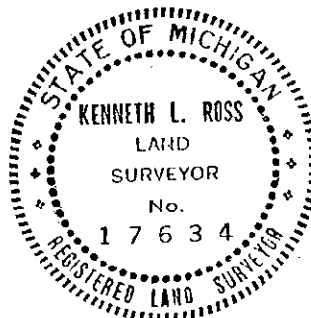

Peer Group Reviewed and Approved  
Date: 6-14-95  
Kenneth L. Ross  
Mason County Surveyor

Signed by *Kenneth L. Ross* Date *6-14-95*

Surveyor's Michigan License No. *17634*