

DEC 18 1995

COMMISSION

LAND CORNER RECORDATION CERTIFICATE

Filing Requirement of Act 74, Mich. P.A. 1970

For corners in


HASON

(County)

Located In:

Corner Code #/

- 1. Public Land Survey T 20N R 17W M-6
- T R
- T R
- T R
- 2. Property Controlling S T R
- in Section S T R
- 3. Miscellaneous S T R
- Property in Sec. S T R

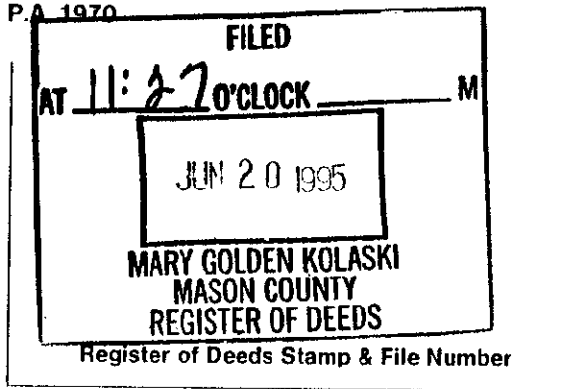

- 4. Lot No. , Recorded Plat
- 5. Private Claims

	A	B	C	D	E	F	G	H	I	J	K	L	M
2	6	5	4	3	2	1							
3													
4	7	8	9	10	11	12							
5													
6	18	17	16	15	14	13							
7													
8	19	20	21	22	23	24							
9													
10	30	29	28	27	26	25							
11													
12	31	32	33	34	35	36							
13													

I, Kenneth L. Ross, in a field survey on MAY 05, 19 95 do hereby certify that under requirements of P.A. 74, Michigan P.A. of 1970, the corner points mentioned in lines 1 and 2 above were in conformance with regulations and rules therefore as required in the current manual of survey instructions of the United States Department of the Interior, Bureau of Land Management or by a decree of a Court of Law and/or that the corner points mentioned in lines 3, 4 and 5 above were in conformance with the rules of the Michigan Board of Land Surveyors or by a Decree of a Court of Law; established, re-established, monumented, re-monumented, recovered, found as expressed below:

NOTE: Not more than 4 corners, all in the same town and range, may be recorded on this certificate.

A. Description of original monument and accessories and/or subsequent restoration:


- M-6 1/4 Corner, 13-20-17 & 18-20-16
- 1837 Mullett & Brookfield
- (1) 18" Beech N 55 W 9 lks
- (2) 6" Beech S 44 W 25 lks

B. Description of corner evidence found and/or method applied in restoring or reestablishing corner:

- M-6 1/4 Corner, 13-20-17 & 18-20-16
- Feb., 1989, M.D.O.T. Fd. 3/4" Pipe in Mon. Box, 0.5' W CL US 31 & in line w/fence W (Job No. 26668)(filed Act 74 Liber 2, Page 195)
- (3) S 50 W 32.03' Face 2" St. Box Post
- (4) Due W 42.95' Face 2" St. Fe. Post
- (5) N 75 W 60.43' 10" Apple
- (6) N 60 W 66.12' 5" Apple Clump
- Sep., 1966, Stephens Set PK nail in asphalt
- (7) N 21 W 123.40' Power Pole
- (8) N 10 E 143.51' 18" Cherry
- (9) Due W 33.09' Fence Post
- (10) S 83 W 113.21' NE Cor. Hse.
- Jun., 1977, Nordland used corner in survey (Liber 1 R.C.S., Page 456)
- Oct., 1977, Ross used corner in survey
- Oct., 1986, Ross Fd. Iron in mon. box
- Sep., 1989, Slawinski used corner in survey (Liber. 385, Page 327)
- Oct., 1991, Slawinski used corner in survey (Liber. 418, Pages 967 & 968)
- Jan., 1993, Ross Fd. Iron in mon. box
- Apr., 1994, Ross Fd. Iron in mon. box
- May, 1995, Ross Fd. corner destroyed by road reconstruction. Corner position restored by reconstruction of M.D.O.T. control survey using surrounding section corners.

C. Description of monument for corner and accessories established to perpetuate locating the position of the corner:

- M-6 1/4 Corner, 13-20-17 & 18-20-16
- Fd witness 5 & 6 above from 1989 M.D.O.T. survey
- Witness 1, 2, 3, 4, 7, 8, 9, 10 above gone
- Set 5/8" X 24" rebar with 2 1/2" alum. cap in mon. box, 0.7' W of CL US31, and is accepted as the best available evidence of the original corner.
- N 73 W 60.39' 10" Apple
- S 80 W 117.39' NE Cor. Hse.
- S 31 W 114.03' Power Pole
- N 32 W 88.99' Power Pole
- N 58 W 66.00' 5" Apple Clump

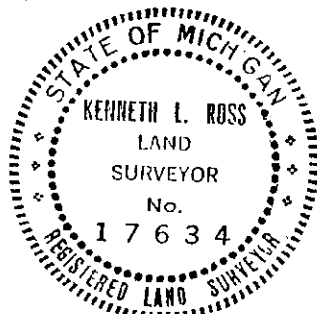

Peer Group Reviewed and Approved
 Date: 6-14-95
 Kenneth L. Ross
 Mason County Surveyor

Signed by [Signature] Date 6-14-95

Surveyor's Michigan License No. 17634