

**SURVEY &  
REMONUMENTATION**

DEC 18 1995


**COMMISSION**

**LAND CORNER RECORDATION CERTIFICATE**

Filing Requirement of Act 74, Mich. P.A. 1970

For corners in

<u>MASON</u> <small>(County)</small>	Located In:	Corner Code: #/
1. Public Land Survey	T 20N R 17W	M-8
	T R	
	T R	
	T R	
2. Property Controlling in Section	S T R	
	S T R	
3. Miscellaneous Property in Sec.	S T R	
	S T R	

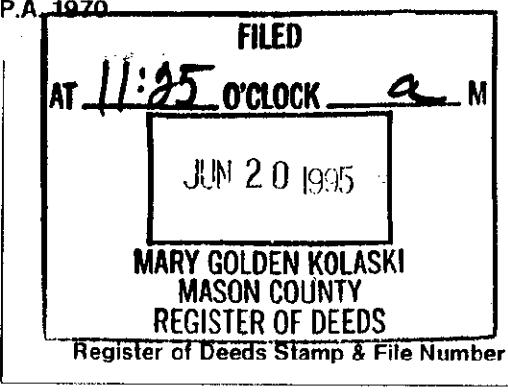

- 4. Lot No. \_\_\_\_\_, Recorded Plat \_\_\_\_\_
- 5. Private Claims \_\_\_\_\_

	A	B	C	D	E	F	G	H	I	J	K	L	M
2	6	5	4	3	2	1							
3													
4	7	8	9	10	11	12							
5													
6	18	17	16	15	14	13							
7													
8	19	20	21	22	23	24							
9													
10	30	29	28	27	26	25							
11													
12	31	32	33	34	35	36							
13													

I, Kenneth L. Ross in a field survey on MAY 05 19 95  
do hereby certify that under requirements of P.A. 74, Michigan P.A. of 1970, the corner points mentioned in lines 1 and 2 above were in conformance with regulations and rules therefore as required in the current manual of survey instructions of the United States Department of the Interior, Bureau of Land Management or by a decree of a Court of Law and/or that the corner points mentioned in lines 3, 4 and 5 above were in conformance with the rules of the Michigan Board of Land Surveyors or by a Decree of a Court of Law; established, re-established, monumented, re-monumented, recovered, found as expressed below:

**NOTE: Not more than 4 corners, all in the same town and range, may be recorded on this certificate.**

A. Description of original monument and accessories and/or subsequent restoration:


M-8 1/4 Corner, 24-20-17 & 19-20-16  
1837 Hullett & Brookfield  
(1) 8" Beech S 71 W 21 lks  
(2) 12" Elm N 27 W 56 lks

B. Description of corner evidence found and/or method applied in restoring or reestablishing corner:

<p>M-8 1/4 Corner, 24-20-17 &amp; 19-20-16 Feb., 1989, M.D.O.T. Fd. 3/4" Steel Pin in Mon. Box flush, 2' E CL US 31 &amp; 4' S Fe. line to W &amp; 8' N CL two track to W (Job No. 26668)(filed Act 74 Liber 2, Page 168) (3) S 70 E 70.29' 8" Tr. Ash (4) S 60 E 95.32' 17" Scotch Pine (5) S 55 W 61.98' 2" Scotch Pine (6) N 85 W 51.99' W. Fence Post Sep., 1966, Stephens Set PK nail (7) S 41 E 48.09' 30" Maple (8) S 76 E 31.72' Fence Post (9) N 82 W 67.74' Champion Ad Sign Nov. 1976, Ross Fd. Iron in mon. box</p>	<p>Dec., 1976, Ross used corner in survey Jun., 1991, Slawinski used corner in survey (Liber. 408, Page 438) May, 1995, Ross Fd. corner destroyed by road reconstruction. Corner position restored by reconstruction of M.D.O.T. control survey using surrounding section corners.</p>
---	--

C. Description of monument for corner and accessories established to perpetuate locating the position of the corner:

M-8 1/4 Corner, 24-20-17 & 19-20-16  
No witness from above found  
Set 5/8" X 24" rebar with 2 1/2" alum. cap in mon. box, 2.3' E of CL US31, and is accepted as the best available evidence of the original corner.  
S 15 E 249.04' Power Pole  
S 75 E 27.59' 14" Culvert N. End  
N 40 E 43.28' 14" Culvert S. End  
N 85 W 76.90' Power Pole  
S 67 W 89.20' 8" Jackpine  
S 19 W 272.79' Power Pole

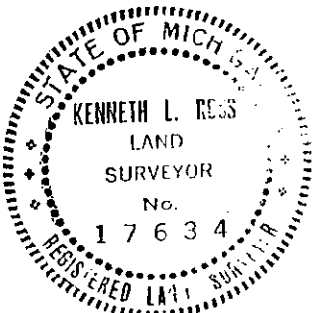

Peer Group Reviewed and Approved  
Date: 6-14-95  
*Kenneth L. Ross*  
Mason County Surveyor

Signed by *Kenneth L. Ross* Date 6-14-95  
Surveyor's Michigan License No. 17634