

DEC 18 1995

COMMISSION

LAND CORNER RECORDATION CERTIFICATE

Filing Requirement of Act 74, Mich. P.A. 1970

For corners in


MASON

(County)

Located In:

Corner Code #:

- 1. Public Land Survey T 20N R 17W H-9
- 2. Property Controlling in Section S T R
- 3. Miscellaneous Property in Sec. S T R

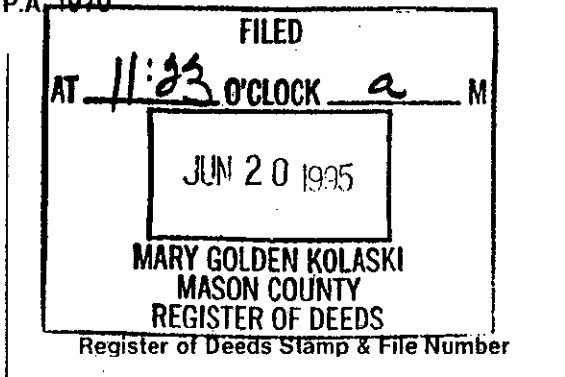

- 4. Lot No. , Recorded Plat
- 5. Private Claims

	A	B	C	D	E	F	G	H	I	J	K	L	M
2	6	5	4	3	2	1							
3													
4	7	8	9	10	11	12							
5													
6	18	17	16	15	14	13							
7													
8	19	20	21	22	23	24							
9													
10	30	29	28	27	26	25							
11													
12	31	32	33	34	35	36							
13													

I, Kenneth L. Ross in a field survey on MAY 05 19 95 do hereby certify that under requirements of P.A. 74, Michigan P.A. of 1970, the corner points mentioned in lines 1 and 2 above were in conformance with regulations and rules therefore as required in the current manual of survey instructions of the United States Department of the Interior, Bureau of Land Management or by a decree of a Court of Law and/or that the corner points mentioned in lines 3, 4 and 5 above were in conformance with the rules of the Michigan Board of Land Surveyors or by a Decree of a Court of Law; established, re-established, monumented, re-monumented, recovered, found as expressed below:

NOTE: Not more than 4 corners, all in the same town and range, may be recorded on this certificate.

A. Description of original monument and accessories and/or subsequent restoration:


H-9 Sec. Cor., 24 & 25-20-17; 19 & 30-20-16
 1837 Mullett & Brookfield
 (1) 10" Beech S 65 W 23 lks
 (2) 7" Beech N 51 W 19 lks

B. Description of corner evidence found and/or method applied in restoring or reestablishing corner:

H-9 Sec. Cor., 24 & 25-20-17; 19 & 30-20-16
 Feb., 1989, H.D.O.T. Fd. 3/4" Iron Pin in Mon. Box
 1.5' E CL US 31-7' N CL Freesoil Rd-3" (Job. No. 26668)(filed Act 74 Liber 2, Page 197)
 (3) N 60 E 94.67' Power Pole
 (4) N 80 E 107.27' 41" Tw. Cherry
 (5) S 50 E 50.26' Power Pole
 (6) S 45 W 58.12' 24" Maple
 Sep., 1966, Stephens Set PK nail on W side of mon. box above ex. iron
 (7) N 55 W 51.61' Road Sign
 (8) S 41 W 58.42' 20" Maple
 (9) S 50 E 50.27' Power Pole
 Dec., 1976, Ross used corner in survey
 Nov., 1980, Ross Fd. Iron in mon. box
 Oct., 1985, Ross Fd. H.D.O.T. PK & Shiner
 Nov., 1986, Ross Fd. Iron in mon. box under asphalt and set PK from witness
 Jun., 1991, Slawinski used corner in survey (Liber. 408, Page 438)
 box 1' E CL hwy US 31 (Liber 1 R.C.S., Page 270) (filed Act 74 Liber 1, Page 266)
 (10) S 53 E 50.28' Power Pole
 (11) S 39 W 58.00' 20" Maple
 (12) N 58 E 116.40' 20" Spruce
 (cont. on back)

C. Description of monument for corner and accessories established to perpetuate locating the position of the corner:

H-9 Sec. Cor., 24 & 25-20-17; 19 & 30-20-16
 Fd witness 3 above from 1989 H.D.O.T. survey
 Witness 1, 2, 4 - 12 above gone
 Set 5/8" X 24" rebar with 2 1/2" alum. cap in mon. box, 1.7' E of CL US31 and 5.7' N of CL Freesoil Rd, and is accepted as the best available evidence of the original corner.
 N 64 E 55.83' Power Pole
 N 63 E 116.50' 18" Pine
 N 47 E 163.42' SW Cor. Bldg.
 S 77 W 123.79' 26" Maple
 S 49 W 124.50' NE Cor. Hse.

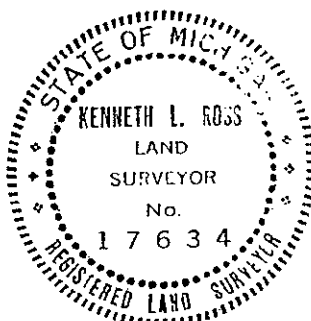

Peer Group Reviewed and Approved
 Date: 6-14-95
 Kenneth L. Ross
 Mason County Surveyor

Signed by [Signature] Date 6-14-95

Surveyor's Michigan License No. 17634

May, 1995, Ross Fd. corner destroyed by road reconstruction. Corner position restored by reconstruction of M.D.O.T. control survey using surrounding section corners.