

**SURVEY &  
REMONUMENTATION**

DEC 18 1995

**COMMISSION**

**LAND CORNER RECORDATION CERTIFICATE**

Filing Requirement of Act 74, Mich. P.A. 1970

For corners in

**MASON**  
(County)

Located In:

Corner Code #/

- 1. Public Land Survey                    T 20N R 17W                    H-10  
                                                   T                    R  
                                                   T                    R  
                                                   T                    R
- 2. Property Controlling                S                    T                    R  
    in Section                                S                    T                    R
- 3. Miscellaneous                        S                    T                    R  
    Property in Sec.                        S                    T                    R
- 4. Lot No.                                Recorded Plat
- 5. Private Claims

**FILED**

AT 11:23 O'CLOCK 9 M

**JUN 20 1995**

**MARY GOLDEN KOLASKI  
MASON COUNTY  
REGISTER OF DEEDS**

Register of Deeds Stamp & File Number

I, Kenneth L. Ross, in a field survey on MAY 05, 19 95, do hereby certify that under requirements of P.A. 74, Michigan P.A. of 1970, the corner points mentioned in lines 1 and 2 above were in conformance with regulations and rules therefore as required in the current manual of survey instructions of the United States Department of the Interior, Bureau of Land Management or by a decree of a Court of Law and/or that the corner points mentioned in lines 3, 4 and 5 above were in conformance with the rules of the Michigan Board of Land Surveyors or by a Decree of a Court of Law; established, re-established, monumented, re-monumented, recovered, found as expressed below:

**NOTE: Not more than 4 corners, all in the same town and range, may be recorded on this certificate.**

	A	B	C	D	E	F	G	H	I	J	K	L	M
2	6		5		4		3		2		1		
3													
4	7		8		9		10		11		12		
5													
6	18		17		16		15		14		13		
7													
8	19		20		21		22		23		24		
9													
10	30		29		28		27		26		25		
11													
12	31		32		33		34		35		36		
13													

A. Description of original monument and accessories and/or subsequent restoration:


M-10 1/4 Corner, 25-20-17 & 30-20-16  
 1837 Mullett & Brookfield  
 (1) 12" Sugar S 42 W 44 lks  
 (2) 6" Beech S 74 W 19 lks

B. Description of corner evidence found and/or method applied in restoring or reestablishing corner:

M-10 1/4 Corner, 25-20-17 & 30-20-16  
 Feb., 1989, M.D.O.T. Set PK & Ref Cap, by record halfway and on line 1.5' E CL US 31-24' S Fe. line W (Job No. 26668)  
 (3) N 80 W 78.01' Power Pole  
 (4) S 35 W 3.80' PK & Ref. Cap  
 Sta. 533+18.20 (POT-Sur CL  
 Jun., 1985, Barnett used corner in survey (Liber 327, Pages 690 & 691)  
 Nov., 1986, Ross located 1/16 line  
 May, 1995, Ross Fd. corner destroyed by road reconstruction. Corner position restored by reconstruction of M.D.O.T. control survey using surrounding section corners.

C. Description of monument for corner and accessories established to perpetuate locating the position of the corner:

M-10 1/4 Corner, 25-20-17 & 30-20-16  
 Fd witness 3 above from 1989 M.D.O.T. survey (may be typographical error)  
 Witness 1, 2, 4 above gone  
 Set 5/8" X 24" rebar with 2 1/2" alum. cap in mon. box, 2.0' E of CL US31, and is accepted as the best available evidence of the original corner.  
 N 82 E 46.87' Tele. Box  
 N 54 E 41.85' 14" Culvert S. End  
 N 27 E 76.51' 14" Culvert N. End  
 N 67 W 56.21' Tele. Box  
 N 81 W 178.01' Power Pole

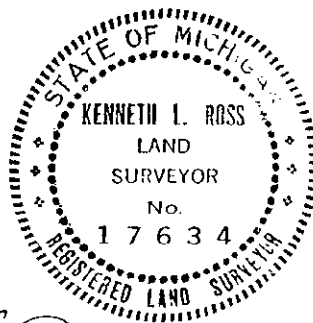

Signed by [Signature] Date 6-14-95

Surveyor's Michigan License No. 17634

Peer Group Reviewed and Approved  
 Date: 6-14-95  
 Kenneth L. Ross  
 Mason County Surveyor