

**SURVEY &  
REMONUMENTATION**


DEC 18 1995

COMMISSION

**LAND CORNER RECORDATION CERTIFICATE**  
Filing Requirement of Act 74, Mich. P.A. 1970

For corners in

<u>MASON</u> (County)	Located In:	Corner Code #:
1. Public Land Survey	T 20N R 17W	M-11
	T R	
	T R	
	T R	
2. Property Controlling in Section	S T R	
	S T R	
3. Miscellaneous Property in Sec.	S T R	
	S T R	

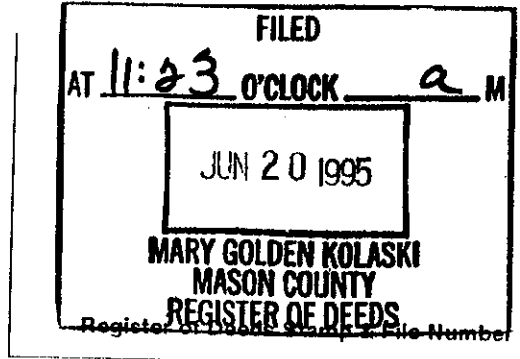

4. Lot No. \_\_\_\_\_, Recorded Plat \_\_\_\_\_  
5. Private Claims \_\_\_\_\_

I, Kenneth L. Ross, in a field survey on MAY 05, 19 95 do hereby certify that under requirements of P.A. 74, Michigan P.A. of 1970, the corner points mentioned in lines 1 and 2 above were in conformance with regulations and rules therefore as required in the current manual of survey instructions of the United States Department of the Interior, Bureau of Land Management or by a decree of a Court of Law and/or that the corner points mentioned in lines 3, 4 and 5 above were in conformance with the rules of the Michigan Board of Land Surveyors or by a Decree of a Court of Law; established, re-established, monumented, re-monumented, recovered, found as expressed below:

**NOTE: Not more than 4 corners, all in the same town and range, may be recorded on this certificate.**

A	B	C	D	E	F	G	H	I	J	K	L	M
2	6	5	4	3	2							
3												
4	7	8	9	10	11	12						
5												
6	18	17	16	15	14	13						
7												
8	19	20	21	22	23	24						
9												
10	30	29	28	27	26	25						
11												
12	31	32	33	34	35	36						
13												

A. Description of original monument and accessories and/or subsequent restoration:

- M-11 Sec. Cor., 36 & 25-20-17; 30 & 31-20-16  
1837 Mullett & Brookfield  
(1) 14" Tree ? N 78 W 50 lks  
(2) 10" Tree ? S 47 W 19 lks


B. Description of corner evidence found and/or method applied in restoring or reestablishing corner:

- M-11 Sec. Cor., 36 & 25-20-17; 30 & 31-20-16  
Feb., 1989, M.D.O.T. Fd. 3/4" Pipe in Mon. Box, 3' E Ex. US 31 CL (Job No. 26668)(filed Act 74 Liber 2, Page 198)  
(3) N 45 E 46.44' Top Cutoff Tele. Pole  
(4) S 60 W 55.34' Face Rd. Sign Post  
(5) N 68 W 115.07' Power Pole  
(6) N 28 W 107.80' Face 2" Spruce  
Apr., 1964, Stephens Fd. 1" Iron bar in mon. box  
Jun., 1985, Barnett used corner in survey (Liber 327, Pages 690 & 691)  
Nov., 1986, Ross Fd. Iron in mon. box  
Apr., 1988, Ross Fd. Iron in mon. box  
May, 1995, Ross Fd. corner destroyed by road

reconstruction. Corner position restored by reconstruction of M.D.O.T. control survey using surrounding section corners.

C. Description of monument for corner and accessories established to perpetuate locating the position of the corner:

- M-11 Sec. Cor., 36 & 25-20-17; 30 & 31-20-16  
Fd witness 5 & 6 above from 1989 M.D.O.T. survey  
Witness 1, 2, 3, 4 above gone  
Set 5/8" X 24" rebar with 2 1/2" alum. cap in mon. box, 2.5' E of CL US31 and on CL Freeman Rd, and is accepted as the best available evidence of the original corner.  
S 23 W 139.04' Power Pole  
S 13 E 182.28' Power Pole  
N 21 E 139.45' Power Pole  
N 26 W 108.03' Face of 4" Spruce  
N 70 W 115.10' Power Pole

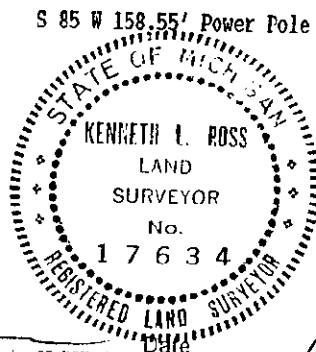

Signed by [Signature] Date 6-14-95  
Surveyor's Michigan License No. 17634

Peer Group Reviewed and Approved  
Date: 6-14-95  
[Signature]  
Kenneth L. Ross  
Mason County Surveyor