LAND CORNER RECORDATION CERTIFICATE

Filing Requirement of Act 74, Mich. P.A. 1970

For corners in
MECOSTA
(County)

		Located In:	Corner Code ##
1. Public Land Survey		T 13 N R 9 W	N-5
		T ____ R ____	N-4
		T ____ R ____	
		T ____ R ____	
2. Property Controlling	S ____	T ____ R ____	
in Section	S ____	T ____ R ____	
3. Miscellaneous	S ____	T ____ R ____	
Property in Sec.	S ____	T ____ R ____	

Register of Deeds Stamp & File Number

4. Lot No. _____ , Recorded Plat _____
5. Private Claims _____

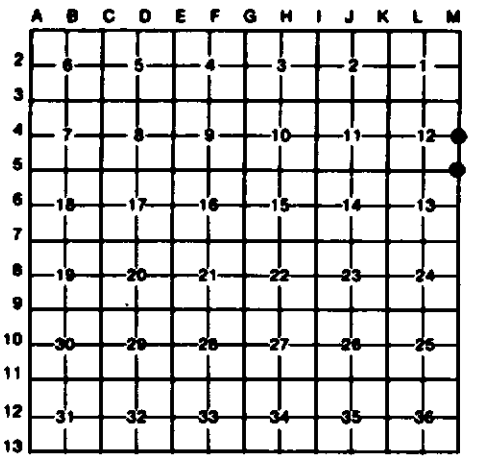

I, CARL F. ROSER, in a field survey on AUGUST 6, 19 85, do hereby certify that under requirements of P.A. 74, Michigan P.A. of 1970, the corner points mentioned in lines 1 and 2 above were in conformance with regulations and rules therefore as required in the current manual of survey instructions of the United States Department of the Interior, Bureau of Land Management or by a decree of a Court of Law and/or that the corner points mentioned in lines 3, 4 and 5 above were in conformance with the rules of the Michigan Board of Land Surveyors or by a Decree of a Court of Law; established, re-established, monumented, re-monumented, recovered, found as expressed below:

NOTE: Not more than 4 corners, all in the same town and range, may be recorded on this certificate.

A. Description of original monument and accessories and/or subsequent restoration:

N-5

N-4

B. Description of corner evidence found and/or method applied in restoring or reestablishing corner:

N-5
RE-ESTABLISHED NE COR. SEC. 13 1/2 WAY AND ON LINE BTWN. FD. 1/4 COR. TO N AND FD. 1/4 COR. TO S. CTR. OLD OVERGROWN MARSH TRAIL (N70°±W) IS 12'± 3' S. OLD FIELD DERN E'LY W/OLD FN. FURTHER E. IS 16'±4' SOUTH.

N-4
RECOVERED OLD IRON AND TILE FOR E 1/4 COR. SEC. 12. COR. IS IN APPROX. CTR. OLD OVERGROWN N-S TWP. RD. COR. IS IN LINE W/OLD FN. REMAINS N'LY. OLD FN. COR. (FN. REMAINS E AND S) IS 29' E.

C. Description of monument for corner and accessories established to perpetuate locating the position of the corner:

N-5
DROVE 5/8"x 34" RE-ROD W/RLS CAP; SET CED. POST W/LOC. TAG.
18" TWIN BEECH N45°E 32.22'
12" R. OAK S85°E 47.12'
3" R. OAK S25°E 15.90'
20" W. OAK S40°W 31.75'
CTR. N-S WINDING TRAIL DUE W 8'
TRAIL (WINDING N77°±W) DUE S 45'±2'

N-4
FD. 1 1/8" IRON SHAFT W/FLANGE 4" DOWN AND 6" VIT. TILE; ADDED CED. POST W/LOC. TAG.
5" R. OAK S45°E 29.80'
5" & 4" R.OAK S50°W 6.47'
8" R. OAK N75°W 37.58'
8" R. OAK N15°W 24.08'
CTR. N-S WINDING TRAIL DUE E 10'

STATE OF MICHIGAN
CARL F. ROSER
LAND SURVEYOR
No. 12028
REGISTERED LAND SURVEYOR

Signed by Carl F. Roser 3-29-89 Date _____

Surveyor's Michigan License No. 12028

FORM APPROVED BY MICHIGAN STATE BOARD OF LAND SURVEYORS, JAN. 29, 1971
REVISED MAY 14, 1975
REVISED JAN., 1983