LAND CORNER RECORDATION CERTIFICATE

Filing Requirement of Act 74, Mich. P.A. 1970

For corners in
(County)

	Located In:	Corner Code ##
1. Public Land Survey	T 13 N R 9 W	N-6
	T ___ R ___	
	T ___ R ___	
	T ___ R ___	
2. Property Controlling	S 13 T ___ R ___	13
in Section	S ___ T ___ R ___	
3. Miscellaneous	S ___ T ___ R ___	
Property in Sec.	S ___ T ___ R ___	

Register of Deeds Stamp & File Number

4. Lot No. _____ , Recorded Plat _____
5. Private Claims _____

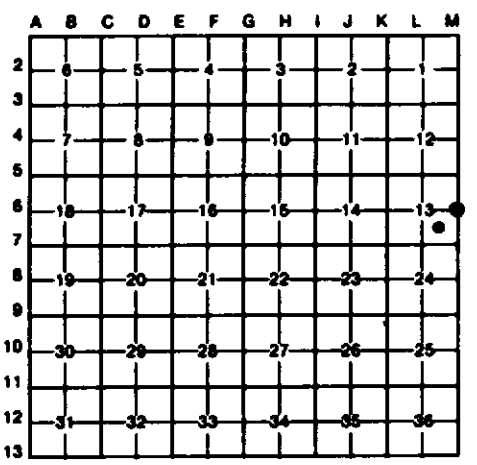

I, CARL F. ROSER, in a field survey on AUGUST 1ST, 19 85, do hereby certify that under requirements of P.A. 74, Michigan P.A. of 1970, the corner points mentioned in lines 1 and 2 above were in conformance with regulations and rules therefore as required in the current manual of survey instructions of the United States Department of the Interior, Bureau of Land Management or by a decree of a Court of Law and/or that the corner points mentioned in lines 3, 4 and 5 above were in conformance with the rules of the Michigan Board of Land Surveyors or by a Decree of a Court of Law; established, re-established, monumented, re-monumented, recovered, found as expressed below:

NOTE: Not more than 4 corners, all in the same town and range, may be recorded on this certificate.

A. Description of original monument and accessories and/or subsequent restoration:

N-6
N-6 CONT.
13

B. Description of corner evidence found and/or method applied in restoring or reestablishing corner:

N-6
RECOVERED OLD IRON FOR E1/4 COR SEC. 13. COR FITS CO. SURVEYOR, L.H.JONE'S 1907, SURVEY IN SEC. 13, (RECORDED IN LIB. OF CO. SURVEYORS RECORDS AT REG. OF DEEDS). CORNER IS IN CTR. OF OLD N-6 BUILT-UP, TWP. ROAD GRADE, W/SIDE DITCHES (NOW ITS A GROWN 2-TRACK).

N-6 CONT.

13
ESTABLISHED SE COR. NW 1/4, SE 1/4, SEC 13; PER STANDARD B.L.M. INSTRUCTIONS.

C. Description of monument for corner and accessories established to perpetuate locating the position of the corner:

N-6
FD 3"x(1/4" TO 3/4"THICK)x 18" OLD IRON; DROVE 5/8"x 34" RE-ROD W/ RLS CAP, THRU OLD 15" STEEL CMP CROSS CULVERT.

12" ASH	N25°W	44.35'
12" SMP OAK	N45°E	22.89'
16" MAPLE	S75°E	19.83'
10" B CHERRY	S50°W	21.27'

N-6 CONT.
SET CED POST W/ LOC TAG DUE W 16.5'
FN. COR. (FN. E&B) DUE E 21'

13
DROVE 5/8"x 34" REROD W/RLS CAP; SET CED POST W/ LOC TAG.

10" MAPLE	N05°E	6.8'
9" W PINE	S40°E	39.1'
3" MAPLE	DUE S	31.1'
3" MAPLE	S60°W	43.7'
FD 1/2"X 18" REROD		
FLUSH	N24°23'W	12.25'
E'LY EDGE RV	N77°W	304'
S'LY EDGE RV	DUE W	291'±2'

STATE OF MICHIGAN
CARL F. ROSER
LAND SURVEYOR
No. 12028
REGISTERED LAND SURVEYOR

Signed by Carl F. Roser 3-29-89 Date _____

Surveyor's Michigan License No. 12028

FORM APPROVED BY MICHIGAN STATE BOARD OF LAND SURVEYORS, JAN. 28, 1971
REVISED MAY 14, 1975
REVISED JAN., 1983