LAND CORNER RECORDATION CERTIFICATE

Filing Requirement of Act 74, Mich. P.A. 1970

For corners in
MECOSTA
(County)

		Located In:	Corner Code ##
1. Public Land Survey		T 13 N R 9 W	K-7
		T ____ R ____	L-7
		T ____ R ____	
		T ____ R ____	
2. Property Controlling	S 13	T ____ R ____	12
in Section	S ____	T ____ R ____	
3. Miscellaneous	S 13	T ____ R ____	404.8' E
Property in Sec.	S ____	T ____ R ____	OF CORE 12.

Register of Deeds Stamp & File Number

4. Lot No. _____, Recorded Plat _____
5. Private Claims _____

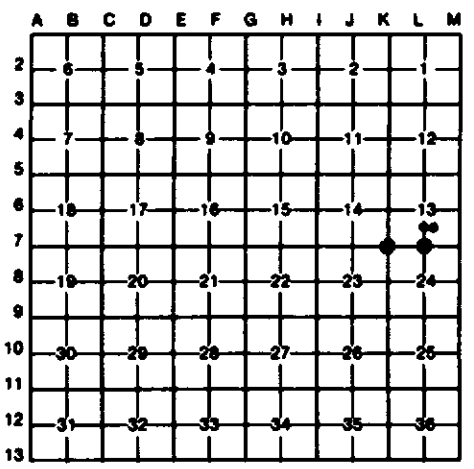

I, CARL F. ROSER, in a field survey on AUGUST 7, 19 85, do hereby certify that under requirements of P.A. 74, Michigan P.A. of 1970, the corner points mentioned in lines 1 and 2 above were in conformance with regulations and rules therefore as required in the current manual of survey instructions of the United States Department of the Interior, Bureau of Land Management or by a decree of a Court of Law and/or that the corner points mentioned in lines 3, 4 and 5 above were in conformance with the rules of the Michigan Board of Land Surveyors or by a Decree of a Court of Law; established, re-established, monumented, re-monumented, recovered, found as expressed below:

NOTE: Not more than 4 corners, all in the same town and range, may be recorded on this certificate.

A. Description of original monument and accessories and/or subsequent restoration:

K-7	L-7	12	*
ACCEPTED 1/2" RE-ROD FOR SW COR. SEC. 13. COR. IS RLS DUANE WOOD 1978 COR. OF RECORD. COR IS IN CTR. DIRT ROADS N-S-E-W.	ACCEPTED FD. 1/2" RE-ROD AND STONE FOR S 1/4 COR SEC. 13. COR. IS RLS DUANE F. WOOD 1978 COR. OF RECORD. COR. FITS CO. SURVEYOR, L.W. JUNE, 1907 SURVEY IN SEC. 13; 1912 SURVEY IN SEC. 24; RECORDED IN LIB. OF CO. SURVEYORS RECORDS AT REG. OF DEEDS.	RECOVERED 1/4"x 5"x 6"± IRON AND STONE FOR SW COR, NW 1/4 SE 1/4, SEC. 13. COR. FITS CO. SURVEYOR, L.W. JUNE 1907 SURVEY, RECORDED IN LIB. OF CO. SURVEYORS RECORDS AT REG. OF DEEDS. JUNE SAID "OLD MARKED STONE FOR COR."	ESTABILISHED SW COR., SE 1/4, NW 1/4, SE 1/4, SEC. 13; PER STD B.L.M. INSTRUCTIONS. COR. FALLS IN CTR. OF GRAVEL ENTRANCE RD; S76°30'E, 404.76' FROM SW COR., NW 1/4, SE 1/4, OF S-13.

B. Description of corner evidence found and/or method applied in restoring or reestablishing corner:

K-7	L-7	12	*


C. Description of monument for corner and accessories established to perpetuate locating the position of the corner:

K-7

FD. 1/2" RE-ROD.

6 11" ASH	S30°W	60.75'
6 COR.FN.POST	S40°E	42.20'
6 12" W.PINE	N45°E	83.81'

6 = RLS DUANE WOOD WIT.

L-7

FD. 1/2" RE-ROD W/RLS CAP 017741; ON SE SIDE 1 1/2'±x 2'± STONE; ADDED CED. POST W/LOC. TAG.

28" ASH	N50°W	57.55'
34" ASH	N10°W	65.77'
13" APPLE	N75°E	21.72'
9" ASPEN	S30°W	2.18'
W.EDGE RIVER	DUE E	59'±1'

12

DROVE 5/8"X 34" RE-ROD W/RLS CAP BESIDE FD. IRON AND STONE; SET CED. POST W/LOC. TAG.

5" W.OAK	S50°W	14.29'
4" R.OAK	N50°W	15.72'
12" W.OAK	N15°W	33.81'
CTR. N-S DIRT RD.	DUE E	11'
CTR. DIRT RD.(S75°E)	DUE N	14'

*****

DROVE 5/8"X 34" RE-ROD W/RLS CAP.

20" BEECH	S75°E	82.55'
10" W. OAK	S45°E	102.72'
SET CED. POST	DUE N	17'
W EDGE RIVER	S77°E	243'

Signed by Carl F. Roser 3-29-89 Date _____

Surveyor's Michigan License No. 12028

STATE OF MICHIGAN
CARL F. ROSER
LAND SURVEYOR
No. 12028
REGISTERED LAND SURVEYOR

FORM APPROVED BY MICHIGAN STATE BOARD OF REGISTRATION FOR PROFESSIONAL ENGINEERS AND LAND SURVEYORS, 1963