LAND CORNER RECORDATION CERTIFICATE

Filing Requirement of Act 74, Mich. P.A. 1970

For corners in
MECOSTA
(County)

	Located In:	Corner Code ##
1. Public Land Survey	T 13 N R 9 W	N-7
	T ____ R ____	
	T ____ R ____	
	T ____ R ____	
2. Property Controlling	S 13 T ____ R ____	16
in Section	S ____ T ____ R ____	
3. Miscellaneous	S 13 T ____ R ____	6=2007.5' N
Property in Sec.	S ____ T ____ R ____	OF CODE 16.

Register of Deeds Stamp & File Number

4. Lot No. _____ , Recorded Plat _____
5. Private Claims _____

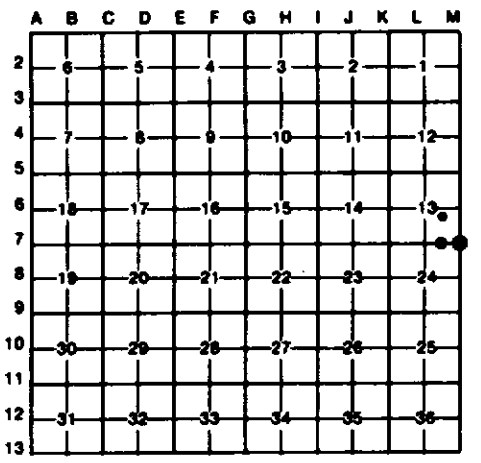

I, CARL F. ROSER , in a field survey on AUGUST 1ST , 19 85 , do hereby certify that under requirements of P.A. 74, Michigan P.A. of 1970, the corner points mentioned in lines 1 and 2 above were in conformance with regulations and rules therefore as required in the current manual of survey instructions of the United States Department of the Interior, Bureau of Land Management or by a decree of a Court of Law and/or that the corner points mentioned in lines 3, 4 and 5 above were in conformance with the rules of the Michigan Board of Land Surveyors or by a Decree of a Court of Law; established, re-established, monumented, re-monumented, recovered, found as expressed below:

NOTE: Not more than 4 corners, all in the same town and range, may be recorded on this certificate.

A. Description of original monument and accessories and/or subsequent restoration:

N-7

N-7 CONT.

16

6

B. Description of corner evidence found and/or method applied in restoring or reestablishing corner:

N-7

RECOVERED REMAINS OF OLD WOOD STAKE POINT FOR SE COR. SEC. 13; BUR, SCALPED, FD. REMAINS OF WOOD, 3" IN DIAMETER, THAT TAPERED DOWN TO A POINT 14" DEEP. CO. SURVEYOR, L.N.JUNE CALLED FOR STAKE IN 1907 (RECORDED IN LIB. OF CO. SUR'S RECORDS AT REG. OF DEEDS). COR. IS IN LINE (LOOKING N) N/OLD SEC. LINE FN. (N77°W). R/W FN. REMAINS S'LY IS 33' N.

N-7 CONT.

16

ESTABILISH SE COR, SW 1/4, SE 1/4, SEC. 13; PER STD. B.L.M. INSTRUCTIONS. COR FALLS AT CORNER OF OLD FENCE (FN REMAINS N & S77°E). COR. FITS CO. SURVEYOR, L.N.JUNE'S 1907, SURVEY IN SEC 13.

6

ESTABILISH NE COR, SE 1/4, NW 1/4, SE 1/4, SEC. 13; PER STD. B.L.M. INSTRUCTIONS, N00°02'07"W, 2007.51' FROM CODE 16.

C. Description of monument for corner and accessories established to perpetuate locating the position of the corner:

N-7

FD REMAINS OF OLD WOOD STK; REPLACED W/ 5/8" X 34" RE-ROD W/ RLS CAP.

22" R.OAK	N80°W	31.95'
8" PIPE COR		
FN POST	N45°E	19.6'
8" ELM IN CLUMP		
OF 3	S55°E	70.14'
11" B CHERRY	S30°W	44.72'

N-7 CONT.

6"SUGAR MAPLE	N30°W	46.75'
SET CED POST W/LOC TAG	DUE N	16.5'
FD 1/2" REROD	N4°26'W	7.25'
CTR N-S DIRT RD	DUE N	3'±1'
CTR DIRT RD EAST	DUE S	22'±2'

16

DROVE 1"X 5' PIPE W/ RLS CAP; SET CED POST W/ LOC TAG.

6" MAPLE	N30°E	23.1'
8" ASH	N50°W	22.1'
4" MAPLE	S70°W	23.0'

6

DROVE 5/8"X 34" RE-ROD W/RLS CAP; SET CEDAR POST.

10"& 6"B.CHERRY	S60°E	4.81'
8" TWIN MAPLE	S20°W	22.78'
28" W PINE	N20°W	31.52'
W'LY EDGE RV.	DUE S	246'±2'
CTR. TRAIL RD.(NE-SW)	DUE N	76'

Signed by Carl F. Roser 3-29-89 Date _____

Surveyor's Michigan License No. 12028

STATE OF MICHIGAN
CARL F. ROSER
LAND SURVEYOR
No. 12028
REGISTERED LAND SURVEYOR

FORM APPROVED BY MICHIGAN STATE BOARD OF SURVEYORS, JAN. 20, 1971
REVISED MAY 14, 1975
REVISED JAN., 1983