

SURVEY & REMONUMENTATION
MECOSTA COUNTY REMONUMENTATION PROGRAM

JUL 16 1997

CORNER APPROVED BY PEER GROUP ON June 13, 1997

JUL -2 11:35

LAND CORNER RECORDATION CERTIFICATE

Filing Requirement of Act 74, Mich. P.A. 1970

1997

For corners in
Mecosta
 (County) Located in: _____ Corner Code # _____
 Hinton Twp.

Joanne Brown
 Register of Deeds
 Mecosta County

1. Public Land Survey	SEC 10	T13N	R08W	H-3
		T	R	
		T	R	
		T	R	
2. Property Controlling in Section	S	T	R	
	S	T	R	
3. Miscellaneous Property in Sec.	S	T	R	
	S	T	R	

Register of Deeds Stamp & File Number

4. Lot No. _____, Recorded Plat _____
 5. Private Claims _____

	A	B	C	D	E	F	G	H	I	J	K	L	M
1													
2	6	5	4	3	2	1							
3													
4	7	8	9	10	11	12							
5													
6	18	17	16	15	14	13							
7													
8	19	20	21	22	23	24							
9													
10	30	29	28	27	26	25							
11													
12	31	32	33	34	35	36							
13													

I, James J. Keller, in a field survey on April 15 19 97, do hereby certify that under requirements of P.A. 74, Michigan P.A. of 1970, the corner points mentioned in lines 1 and 2 above were in conformance with regulations and rules therefore as required in the current manual of survey instructions of the United States Department of the Interior, Bureau of Land Management or by a decree of a Court of Law and/or that the corner points mentioned in lines 3, 4 and 5 above were in conformance with the rules of the Michigan Board of Land Surveyors or by a Decree of a Court of Law; established, re-established, monumented, re-monumented, recovered, found as expressed below:

NOTE: Not more than 4 corners, all in the same town and range, may be recorded on this certificate.

A. Description of original monument and accessories and/or subsequent restoration:

November 24, 1838, Noah Brookfield, Deputy Surveyor GLO "Set Qr Sec post in True Line"
 15" Beech S72°E 22 Links = 14.52' 10" Beech N37°W 10 links = 6.6'

November 23-27, 1905, Lyman W. June Mecosta County Surveyor "Old Iron Corner = Gas Pipe"
 6" R. Elm SE 81.4' 5" Walnut 48.5'

May 21, 1918 E.E. Sours (MCRC Road Survey) NOTE: "Recorded June 1919, Page 139, Surveyor's Record". No Witnesses Given.

July 29, 1918 E.E. Sours (MCRC Road Survey) NOTE: "Recorded June 1919 Page 139, Surveyor's Record"
 "1/4 Corner 3-10" 6" R Elm SE 81.4' 5" B. Walnut 48.5'

1948 FAS 8-48 (1) CS 54-31 Road Plans. POE 1/4 Corner 3-10

March 24, 1975, Gerald J. Gray #17741 (LCRC L1 Pg 124) "Set PK Nail by Witnesses"
 14" Walnut N45°E 48.29' T. Pole S55°E 53.15' R.O.W. Marker S50°W 56.75'

B. Description of corner evidence found and/or method applied in restoring or reestablishing corner:

April 15, 1997, James J. Keller #10693 " Found 1 1/2" Iron pipe 3' 6" Deep"

Center 24" Walnut stump N50°E 48.8' +/-
 Set 60d & tag SE side 36" Walnut N73°E 94.82'
 Set PK nail & tag SW side P. Pole S48°E 54.07'
 N. Corner Highway Marker S65°W 56.74'
 Set 60d & tag N face Telephone/Service pole N43°W 56.05'

APPROVED BY MECOSTA CO. PEER GROUP
 IN ACCORDANCE WITH P.A. 343 of 1990

James J. Knapp
 CHAIRMAN
 DATE JUNE 13, 1997

C. Description of monument for corner and accessories established to perpetuate locating the position of the corner:

Accepted 1-1/2" IP 3' 6" deep & set Remonumentation Monument over it in box as a careful and faithful perpetuation of the position of the original corner.


Set 60d & tag N face telephone/service pole N43°W 56.05'
 Set 60d & tag SE side 36" Walnut N73°E 94.82'
 Set PK nail & tag SW side P. pole S48°E 54.07'
 Found North corner highway marker S65°W 56.74'



Signed by James J. Keller Date April 15, 1997
 Surveyor's Michigan License No. 10693

11.00

JJK LJH
April 15 1997

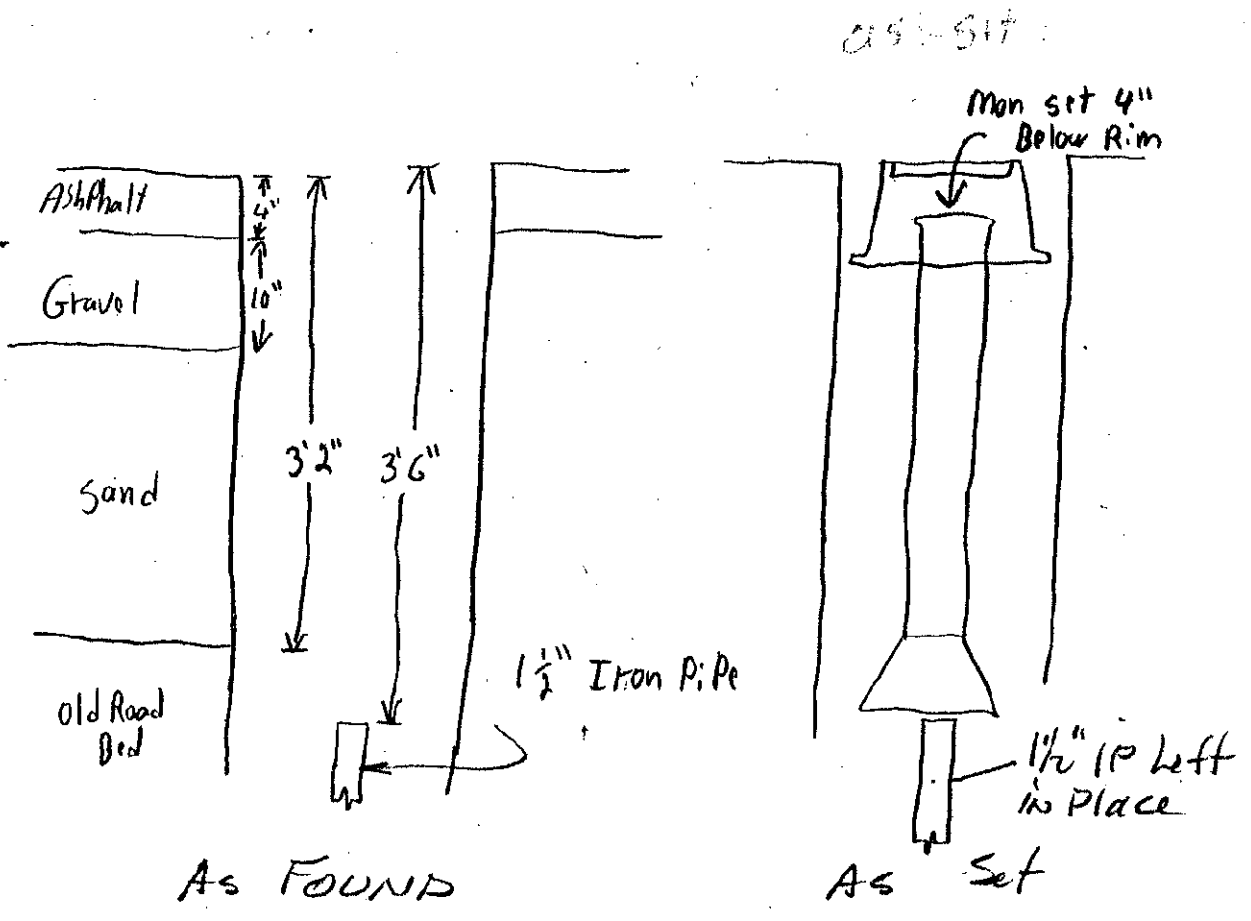

SURVEY &
REMONUMENTATION
JUL 10 1997
COMMISSION