

SURVEY & REMONUMENTATION

JUL 10 1997

COMMISSION

CORNER APPROVED BY PEER GROUP ON LAND CORNER RECORDATION CERTIFICATE

CORNER APPROVED BY PEER GROUP ON June 13, 1997

Filing Requirement of Act 74, Mich. P.A. 1970

JUL -2 A11:35 1997

Joanne Brown Register of Deeds Mecosta County

Form with fields: For corners in Mecosta (County), Located In: Hinton Twp., Corner Code #, 1. Public Land Survey SEC 10 T13N R 8W I-3, 2. Property Controlling in Section, 3. Miscellaneous Property in Sec., 4. Lot No., Recorded Plat, 5. Private Claims

Register of Deeds Stamp & File Number

I, James J. Keller, in a field survey on April 16, 1997, do hereby certify that under requirements of P.A. 74, Michigan P.A. of 1970, the corner points mentioned in lines 1 and 2 above were in conformance with regulations and rules therefore as required in the current manual of survey instructions of the United States Department of the Interior, Bureau of Land Management or by a decree of a Court of Law and/or that the corner points mentioned in lines 3, 4 and 5 above were in conformance with the rules of the Michigan Board of Land Surveyors or by a Decree of a Court of Law, established, re-established, monumented, re-monumented, recovered, found as expressed below.

NOTE: Not more than 4 corners, all in the same town and range, may be recorded on this certificate.

A. Description of original monument and accessories and/or subsequent restoration:

November 24, 1838, Noah Brookfield "Set Post Cor. of 2,3,10 & 11" 12" Beech N49°E 24 Links = 15.84' 10" Sugar S56° 29 Links = 19.14'

November 23 - 27, 1905, Lyman W. June Mecosta County Surveyor (Surveyor's record, Page 139) "Old Stone Corner" 12" Elm N30°E 56 Links = 36.96'

May 21, 1918 E.E. Sours (MCRC Road Survey) NOTE: Recorded June 1919, Page 139, Surveyor's Record. No Witnesses Given

July 29, 1918 E.E. Sours (MCRC Road Survey) NOTE: Recorded June 1919, Page 139, Surveyor's record. 16" Poplar SW 46' 18" Elm NE 36.7'

B. Description of corner evidence found and/or method applied in restoring or reestablishing corner:

April 16, 1997, James J. Keller #10693 "Found Pointed Square Stone 2'-6" Deep 1' N. Centerline 5 Mile Road"

- Set EK nail & tag W side 6"x6" Gate post South 33.54'
Set 60d & tag SW side 26" Elm S45°W 42.62'
Set EK nail & tag N side service pole S76°W 96.29'
Set EK nail & tag E side Distribution pole N15°W 83.50'


APPROVED BY MECOSTA CO. PEER GROUP IN ACCORDANCE WITH P.A. 345 of 1990

James J. Knapp CHAIRMAN DATE JUNE 13, 1997

C. Description of monument for corner and accessories established to perpetuate locating the position of the corner:

Accepted Pointed stone 2' 6" deep and set Remonumentation monument over it as a careful and faithful perpetuation of the position of the original corner.

- Set EK nail & tag E side Distribution pole N15°W 83.50'
Set EK nail & tag W side 6"x6" gate post South 33.54'
Set 60d & tag NW side 26" Elm S45°W 42.62'
Set EK nail & tag N side Service pole S76°W 96.29'

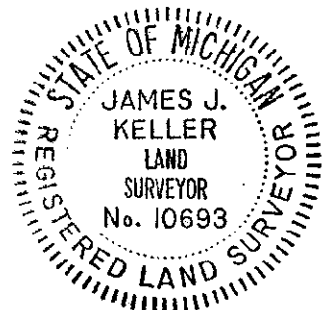


Signed by James J. Keller Date April 16, 1997
Surveyor's Michigan License No. 10693

11.00

JJK LSH
April - 16 - 1997

AS Found

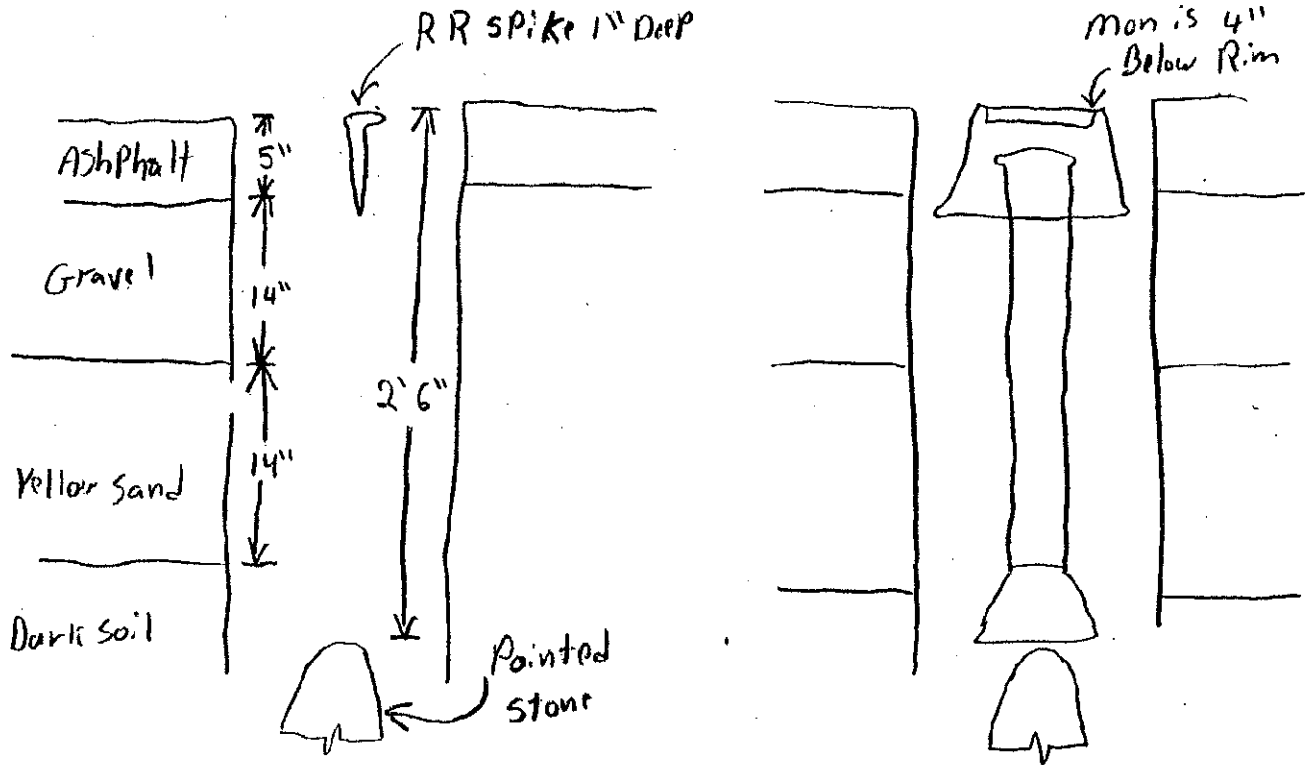

SURVEY &
REMONUMENTATION

JUL 10 1997

COMMISSION