

MAR 03 1999

MECOSTA COUNTY REMONUMENTATION PROGRAM

CORNER APPROVED BY PEER GROUP ON November 13, 1998

STATE OF MICHIGAN  
COUNTY OF MECOSTA  
RECEIVED FOR RECORD

SECTION

LAND CORNER RECORDATION CERTIFICATE

Filing Requirement of Act 74, Mich. P.A. 1970

'98 DEC 28 A8:36

For corners in <u>Mecosta</u> (County)	Located In: <u>Aetna Township</u>	Corner Code # <u>A-2</u>
1. Public Land Survey	SEC 6 T 13N R 10W	<u>A-2</u>
	T R	
	T R	
	T R	
2. Property Controlling in Section	S T R	
	S T R	
3. Miscellaneous Property in Sec.	S T R	
	S T R	
4. Lot No. _____, Recorded Plat _____		
5. Private Claims _____		

*James Brown*  
REGISTER OF DEEDS

Register of Deeds Stamp & File Number

1	A	B	C	D	E	F	G	H	I	J	K	L	M
2	6	5	4	3	2	1							
3													
4	7	8	9	10	11	12							
5													
6	18	17	16	15	14	13							
7													
8	19	20	21	22	23	24							
9													
10	30	29	28	27	26	25							
11													
12	31	32	33	34	35	36							
13													

I, James J. Keller, in a field survey on October 27 1998, do hereby certify that under requirements of P.A. 74, Michigan P.A. of 1970, the corner points mentioned in lines 1 and 2 above were in conformance with regulations and rules therefore as required in the current manual of survey instructions of the United States Department of the Interior, Bureau of Land Management or by a decree of a Court of Law and/or that the corner points mentioned in lines 3, 4 and 5 above were in conformance with the rules of the Michigan Board of Land Surveyors or by a Decree of a Court of Law, established, re-established, monumented, re-monumented, recovered, found as expressed below:

NOTE: Not more than 2 corners, all in the same town and range, may be recorded on this certificate.

A. Description of original monument and accessories and/or subsequent restoration:

- June 21, 1837, John Hodgson, Deputy Surveyor GLO "A Hemlock 12 in Diam. for quarter Section post."
- December 13, 1926, Wm Fargo, Consumers Power Company Dwg #F-5609 "Prorated Set Std Marker"  
16" Pine Stump N25-1/2°E 59-3/4 Links (39.44')  
5" W. Oak S83°W 36 Links (23.76')
- October 8, 1993, Norman L. Ochs, RLS #22439 (Unrecorded Survey #93283B) "Found 2" Pipe, Consumers Power Company Marker"  
20" Black Oak S27°W 54.10'  
12" White Oak S83°W 23.69'  
24" Red Oak N70°W 36.12'  
8" Twin Maple N32°E 39.60'
- December 15, 1994, Norman L. Ochs, RLS #22439 (Vol 001 P105) Newaygo County Remonumentation Program "Accepted 2" Pipe with Consumers Power Co. Cap as a substantial marker for the section corner and is accepted as a careful and faithful re-establishment of the original corner."  
12" W. Oak S83°W 23.69' Spike in South side of tree #3  
20" B. Oak S27°W 54.10' Spike in S.E. side of tree #4  
24" R. Oak N70°W 36.12' Spike in South side of tree #5  
8" Twin Maple N32°E 39.60' Spike in N.W. side of tree #6

B. Description of corner evidence found and/or method applied in restoring or reestablishing corner:


- October 27, 1998, James J. Keller, RLS #10693 (FB 138-W P65)  
Fnd CPCo Standard Marker 2" IP 18" High with Cap  
Fnd 40d SW Sd 23" Oak With Blaze N65°W 36.25'  
Fnd 40d NW Sd 8" Maple With Blaze N37°E 39.58'  
Fnd 40d SE Sd 20" Oak With Blaze S30°W 54.12'  
Fnd 40d S Sd 14" White Oak With Blaze S88°W 23.62'  
Left Bank Muskegon River North 249'±

APPROVED BY MECOSTA CO. PEER GROUP  
IN ACCORDANCE WITH P.A. 345 of 1990

*James H. Knapp*  
CHAIRMAN  
NOV. 13, 1998

C. Description of monument for corner and accessories established to perpetuate locating the position of the corner:

- Accepted 2" IP with Consumers Power Co. Cap as a substantial marker for the section corner and is accepted as a careful and faithful re-establishment of the original corner.  
Set 60d and Tag SW side 23" Oak with Blaze N65°W 36.25'  
Set 60d and Tag NW side 8" Maple with Blaze N37°E 39.58'  
Set 60d and Tag SE side 20" Oak with Blaze S30°W 54.12'  
Set 60d and Tag S side 14" White Oak with Blaze S88°W 23.62'  
Left Bank Muskegon River North 249'±

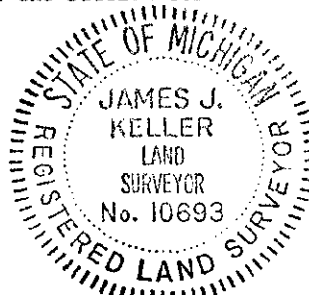

Signed by James J. Keller  
Surveyor's Michigan License No. 10693

Date November 13, 1998