

SURVEY & REMONUMENTATION MECOSTA COUNTY REMONUMENTATION PROGRAM

MAR 03 1999

CORNER APPROVED BY PEER GROUP ON November 13, 1998

LAND CORNER RECORDATION CERTIFICATE

Filing Requirement of Act 74, Mich. P.A. 1970

STATE OF MICHIGAN
COUNTY OF MECOSTA
RECEIVED FOR RECORD

SECTION

For corners in Mecosta (County)	Located In: Aetna Township	Corner Code #
1. Public Land Survey	SEC 6 T 13N R 10W	A-3
	T R	
	T R	
	T R	
2. Property Controlling in Section	S T R	
	S T R	
3. Miscellaneous Property in Sec.	S T R	
	S T R	

'98 DEC 28 A8:37

James Brown
REGISTER OF DEEDS

Register of Deeds Stamp & File Number

4. Lot No. _____, Recorded Plat _____
5. Private Claims _____

	A	B	C	D	E	F	G	H	I	J	K	L	M
1													
2	6	5	4	3	2	1							
3													
4	7	8	9	10	11	12							
5													
6	18	17	16	15	14	13							
7													
8	19	20	21	22	23	24							
9													
10	30	29	28	27	26	25							
11													
12	31	32	33	34	35	36							
13													

I, James J. Keller, in a field survey on October 24 19 98, do hereby certify that under requirements of P.A. 74, Michigan P.A. of 1970, the corner points mentioned in lines 1 and 2 above were in conformance with regulations and rules therefore as required in the current manual of survey instructions of the United States Department of the Interior, Bureau of Land Management or by a decree of a Court of Law and/or that the corner points mentioned in lines 3, 4 and 5 above were in conformance with the rules of the Michigan Board of Land Surveyors or by a Decree of a Court of Law; established, re-established, monumented, re-monumented, recovered, found as expressed below:

NOTE: Not more than 2 corners, all in the same town and range, may be recorded on this certificate.


A. Description of original monument and accessories and/or subsequent restoration:

- November 9, 1837, John Hodgson, Deputy Surveyor GLO, "Set Qr. Sec. Post"
8" Beech N77°E 21 Links (13.86') 18" Maple S69°W 8 Links (5.28')
- December 13, 1926, Wm Fargo, Consumers Power Company Dwg #F-5608, "Accepted Stone and Glass. Set Std. Marker"
36" Pine Stump N27°E 1.46 ch (96.36') 36" Pine Stump S46-1/2°E 44-1/2 Links (29.37')
6" Apple S43-3/4°W 1.00-1/4 ch (66.17')
- June 22, 1938, M.D. Stitt, Consumers Power Company Dwg #HS-4598-G, Muskegon River File
"8W Corner Section 6, CPCo Marker and White National Forest Post" (No Witnesses)
- April 12, 1968 USFS Book 21 Pg 131
36" Pine Stump N27°E 1.46 Ch (96.36') Pine Stump S46-1/2°E 44.5 Links (29.37')
6" Apple S43-3/4°W 1.00-1/4 Ch (66.17')
- September 1987, CPCo. "Fnd 2" Pipe Beside Painted Stone, 15' South of Road to East
P. Pole W 43.79' 8" Pine N44°W 85.74'
12" Pine N64°E 88.00' 36" Maple S80°E 90.22'
- October 30, 1991, James J. Keller, RLS #10693, (FB 107, P130), "Fnd 2" IP 2" Deep, Believed to be CPCo Std. Prop. Marker"
Fnd Form Nail NW Sd 12" Red Pine N38°E 85.70' Fnd Form Nail SE Sd 15" Red Pine N60°E 78.95'
Fnd Form Nail S Sd 36" Maple S77°E 90.20' Fnd Form Nail N Sd Dist. Pole S89°W 43.79'
- October 13, 1993, Norman L. Ochs, RLS #22439 (Unrecorded Survey #93283B) "Fnd 2" Pipe (CPCo Marker)"
8" Red Pine N45°E 85.55' P. Pole W 43.75'
6"-15" Maple S85°E 89.30' 16" Red Pine N60°E 79.00'
- December 15, 1994, Norman L. Ochs RLS #22439 (Vol.1 P106) Newaygo County Remonumentation Program
"Accepted 2" Iron pipe with Consumers Power Co. cap as a substantial marker for the section corner and is accepted as a careful re-establishment of the original corner."
P. Pole West 43.75' Spike in North side of pole #7 16" R. pine N60°E 79.00' Spike in North side of tree #8
8" R. Pine N45°E 85.55' Spike in West side of tree # 10
36" Maple S85°E Spike in North side of tree #11

B. Description of corner evidence found and/or method applied in restoring or reestablishing corner:

- October 24, 1998, James J. Keller, RLS #10693 (FB 138-W, D65) "Found 2" IP 2" Deep, No Cap"
Set 60d SE Sd 10" Red Pine N38°E 85.65'
Fnd PK Nail & Tag #24598 NW Sd 14" Red Pine N53°E 98.70'
Fnd 36" Maple Stump S78°E 90'+
Fnd Pointed Boulder S59°E 44.44'
Fnd Form Nail N Sd P. Pole West 43.74'

See Back for Description C.

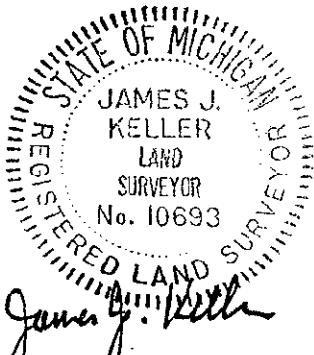

APPROVED BY MECOSTA CO. PEER GROUP
IN ACCORDANCE WITH P.A. 345 of 1996

James G. Knapp
CHAIRMAN
DATE Nov. 13, 1998


C. Description of monument for corner and accessories established to perpetuate locating the position of the corner:

Accepted 2" IP without cap as a substantial marker for the section corner and as a careful re-establishment of the original corner. Cut pipe to 6" below grade and set monument box.

- Set 60d and Tag SE side 10" Red Pine N38°E 85.65'
- Set 60d and Tag above Tag #24598 NW side 14" Red Pine N53°E 98.70'
- Set 60d and Tag S side 36" Maple Stump S78°E 90'±
- Pointed Boulder S59°E 44.44'
- Set 60d and Tag N side P.Pole West 43.74'

Signed by James J. Keller Date Nov. 13 1998
 Surveyor's Michigan License No. 10693

FORM APPROVED BY MICHIGAN STATE BOARD OF LAND SURVEYORS, JAN. 28, 1971
 REVISED MAY 14, 1975
 REVISED JAN., 1983
 ADAPTED FOR WORD PROCESSING MARCH, 1993

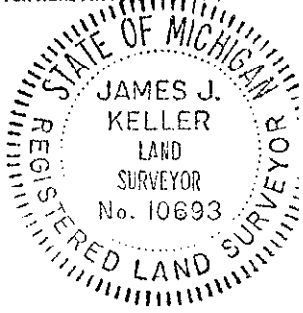

SURVEY &
 REMONUMENTATION

MAR 03 1999

SECTION