

SURVEY & REMONUMENTATION

MECOSTA COUNTY REMONUMENTATION PROGRAM

OCT 26 1999

CORNER APPROVED BY PEER GROUP ON February 12, 1999

LAND CORNER RECORDATION CERTIFICATE

STATE OF MICHIGAN
COUNTY OF MECOSTA
RECEIVED FOR RECORD

SECTION

Filing Requirement of Act 74, Mich. P.A. 1970

'99 JUL -2 P2:59

For corners in <u>Mecosta</u> (County)	Located In: <u>Aetha Twp.</u>	Corner Code # <u>A-4</u>
1. Public Land Survey	SEC 7 T 13N R 10W T _____ R _____ T _____ R _____ T _____ R _____	_____
2. Property Controlling in Section	S _____ T _____ R _____ S _____ T _____ R _____	_____
3. Miscellaneous Property in Sec.	S _____ T _____ R _____ S _____ T _____ R _____	_____
4. Lot No. _____	Recorded Plat _____	
5. Private Claims _____		

James Brown
REGISTER OF DEEDS

Register of Deeds Stamp & File Number

I, James J. Keller, in a field survey on January 28, 1999, do hereby certify that under requirements of P.A. 74, Michigan P.A. of 1970, the corner points mentioned in lines 1 and 2 above were in conformance with regulations and rules therefore as required in the current manual of survey instructions of the United States Department of the Interior, Bureau of Land Management or by a decree of a Court of Law and/or that the corner points mentioned in lines 3, 4 and 5 above were in conformance with the rules of the Michigan Board of Land Surveyors or by a Decree of a Court of Law, established, re-established, monumented, re-monumented, recovered, found as expressed below.

NOTE: Not more than 2 corners, all in the same town and range, may be recorded on this certificate.

A. Description of original monument and accessories and/or subsequent restoration:

- June 21, 1837, John Hodgson, Deputy Surveyor G.L.O. "Set Quarte Section Post" 8" Beech S50°W 28 Links (18.48') 8" Beech N46°W 17 Links (11.22') (GLO Notes Indicate Quarter Post is Midway & on Line NW & SW Section Corners)
- September 10, 1926 William W. Fargo, CPCo. Dwg #F5609 "Proxated Set Tile" 10" White Oak N44-1/4°W 86-1/4 Links (56.92') 14" White Oak N19-3/4°E 58 Links (38.28')
- Circa 1930, W.H. Wright, Mecosta Co. Surveyor, Road Survey 1/4 Corner Concrete Monument & Tile 2652' S of NW corner and 2652' N of SW Corner Sec 7.
- September 15, 1931, CPCo Dwg F5613G "Proxated Set Tile"

B. Description of corner evidence found and/or method applied in restoring or reestablishing corner:

December 9, 1991, James J. Keller, RLS #10693 (FB-107 Pg134)
"Found 6" Clay Tile with + on Concrete 12" Deet by CPCo Witnesses of 1926"
Left RR Spike on Top of Tile to Facilitate Relocation.
Set 30d NE Sd 18" White Oak N41°W 56.95' Set 30d W Sd 28" Oak N18°E 38.16'
Set 30d SW Sd 24" Oak S63°E 11.12' Found 3/4" Iron Rod in Road S36°W 27.04'
Set 30d NW Sd 24" White Oak S65°W 47.33' Set 30d N Sd 24" Oak N72°W 51.06'
Tile is West 8.5' of N-S Barb Fence and 33.7' North of Fence to E and 5' East of East Edge of Gravel, and 0.48' W of Line Between SW and NW Section Corners.

C. Description of monument for corner and accessories established to perpetuate locating the position of the corner:


Accepted 6" Clay Tile and Set Remonumentation Monument in Place of it as a Careful and Faithful Perpetuation of the Original Corner.

- Found 30d and Set 60d and Tad in Place W sd 28" Oak N25°E 37.98'
- Found 30d and Set 60d and Tad in Place SW sd 24" Oak S62°E 11.16'
- Found 30d and Set 60d and Tad in Place NW sd 24" Oak S66°W 37.25'
- Found 30d and Set 60d and Tad in Place N sd 24" Oak S69°W 51.00'
- Found 30d and Set 60d and Tad in Place NE sd 18" Oak N40°W 56.88'
- Found PK and Tag #24598 NW sd 24" Oak S62°E 10.51'
- Monument is 21.57' West of N-S Barbed wire fence.

APPROVED BY MECOSTA CO. PEER GROUP
IN ACCORDANCE WITH P.A. 345 of 1990

James J. Knapp
CHAIRMAN
DATE FEB. 12, 1999

Signed by James J. Keller
Surveyor's Michigan License No. 10693

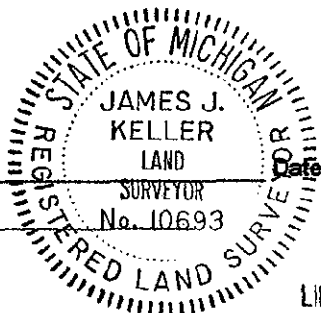

Date June 14, 1999