

MECOSTA COUNTY REMONUMENTATION PROGRAM

OCT 28 1999

CORNER APPROVED BY PEER GROUP ON June 11, 1999

SECTION

LAND CORNER RECORDATION CERTIFICATE

STATE OF MICHIGAN COUNTY OF MECOSTA RECEIVED FOR RECORD

Filing Requirement of Act 74, Mich. P.A. 1970

For corners in Mecosta (County)

Located In: Aetna Twp.

Corner Code #

'99 JUL -2 P2:58

Table with 4 columns: Item, Section, Township, Range, Corner Code #. Includes items like '1. Public Land Survey', '2. Property Controlling in Section', '3. Miscellaneous Property in Sec.'.

James Brown REGISTER OF DEEDS

Register of Deeds Stamp & File Number

4. Lot No. Recorded Plat
5. Private Claims

Grid table with columns A-M and rows 1-13. Contains numbers 1-36 and a dot in cell A2.

I, James J. Keller, in a field survey on September 17, 19 98, do hereby certify that under requirements of P.A. 74, Michigan P.A. of 1970, the corner points mentioned in lines 1 and 2 above were in conformance with regulations and rules therefore as required in the current manual of survey instructions of the United States Department of the Interior, Bureau of Land Management or by a decree of a Court of Law and/or that the corner points mentioned in lines 3, 4 and 5 above were in conformance with the rules of the Michigan Board of Land Surveyors or by a Decree of a Court of Law; established, re-established, monumented, re-monumented, recovered, found as expressed below:

NOTE: Not more than 2 corners, all in the same town and range, may be recorded on this certificate.

A. Description of original monument and accessories and/or subsequent restoration:

Corner Not Set by GLO

June 22, 1938, Consumers Power Company Dwg #HS-4598-G, File # Muskegon River "Oak Post 12" Below Surface. Set Iron' Blazed Pine Stump N38°E 63.4' E1/4 Post East 2652' 14" Oak S88°W 54.5' 16" Oak S25°W 98' 14" Elm N51°W 75.5'

October 29, 1990, James J. Keller, RLS #10693 (FB 107-W P83) "Found 3/4" IP 10" Deep" Found Stump N49°W 79.15 Set 30d E Sd 10" Red Oak N06°W 20.01' Found Blaze on Old White Pine Stump N43°E 63.63' Set 30d S Sd 12" White Pine N79°E 42.99' Set 30d W Sd 15" Ash S22°E 48.20' Center 44" Dead White Oak S27°W 98.53' Set 30d Tw 12" Red Oak S40°W 10.75' E1/4 Corner East 2652.13' Old Fence to South East 40'+ (E R/W Fence Old Road)

December 21, 1990, James J. Keller, RLS #10693 (LCRC L2 P355) "Found 3/4" IP 10" Deep" Found Blaze Pine Stump N43°E 63.63' Found Dead 44" White Oak S27°W 98.53' Found Stump N49°W 79.2' Nail 15" Ash S22°E 48.20' Nail 12" Red Oak S40°W 10.75' Nail 10" Red Oak N06°W 20.01' Nail 12" White Oak N79°E 42.99'


B. Description of corner evidence found and/or method applied in restoring or reestablishing corner:

September 17, 1998, James J. Keller, RLS #10693 (FB 138-W P63) "Found Old 3/4" IP 10" Deep" Found 30d E Sd 10" Red Oak N05°W 20.00' Found 30d S Sd 10" White Oak N79°E 42.90' Found 30d SW Sd 10" White Ash S22°E 48.12' Found Dead White Oak S30°W 98.9' Found 30d NW Sd Twin 10"-15" Red Oak S40°W 10.69' 3/4" IP @ Center is 1.86' North of Straight Line Between E & W 1/4 Corners (A-2 to C-2) and 17.48' East of Straight line between (B-1 & B-3) 3/4" IP @ E 1/4 1/4 Corner (9) is 1.25' South of Straight Line Between E & W 1/4 Corners (A-2 to C-2)

C. Description of monument for corner and accessories established to perpetuate locating the position of the corner:

Accepted 3/4" IP and Set Remonumentation Monument as a Careful and Faithful Perpetuation of the Historical Position of this Corner.

Set 60d & Tag E Sd 10" Red Oak N05°W 20.00' Set 60d & Tag S Sd 10" White Oak N79°E 42.90' Set 60d & Tag SW Sd 10" White Ash S22°E 48.12' Dead White Oak S30°W 98.90' Set 60d & Tag NW Sd Twin 10"-15" Red Oak S40°W 10.69'

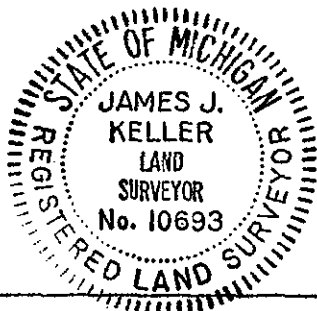

APPROVED BY MECOSTA CO. PEER GROUP IN ACCORDANCE WITH P.A. 345 of 1990

James H. Knapp CHAIRMAN DATE JUNE 11, 1999

Signed by James J. Keller Surveyor's Michigan License No. 10693

Date June 14, 1999

SURVEY &
REMONUMENTATION

OCT 26 1999

SECTION

11 - 10 - 1998

JJK LJH TMB

