

MAR 03 1999

MECOSTA COUNTY REMONUMENTATION PROGRAM

SECTION

CORNER APPROVED BY PEER GROUP ON October 9, 1998

LAND CORNER RECORDATION CERTIFICATE

Filing Requirement of Act 74, Mich. P.A. 1970

STATE OF MICHIGAN
COUNTY OF MECOSTA
RECEIVED FOR RECORD

'98 DEC 28 A8:37

For corners in

Mecosta
(County)

Located In:
Aetna Twp.

Corner Code #

1. Public Land Survey	SEC 4	T13N	R10W	E-3
		T	R	
		T	R	
		T	R	
2. Property Controlling in Section	S	T	R	
	S	T	R	
3. Miscellaneous Property in Sec.	S	T	R	
	S	T	R	

Joanna Bernal
REGISTER OF DEEDS

Register of Deeds Stamp & File Number

4. Lot No. _____, Recorded Plat _____
5. Private Claims _____

I, James J. Keller, in a field survey on September 17, 1998, do hereby certify that under requirements of P.A. 74, Michigan P.A. of 1970, the corner points mentioned in lines 1 and 2 above were in conformance with regulations and rules therefore as required in the current manual of survey instructions of the United States Department of the Interior, Bureau of Land Management or by a decree of a Court of Law and/or that the corner points mentioned in lines 3, 4 and 5 above were in conformance with the rules of the Michigan Board of Land Surveyors or by a Decree of a Court of Law; established, re-established, monumented, re-monumented, recovered, found as expressed below:

	A	B	C	D	E	F	G	H	I	J	K	L	M
2	6	5			4			3		2			1
3					●								
4	7	8			9			10		11			12
5													
6	18	17			16			15		14			13
7													
8	19	20			21			22		23			24
9													
10	30	29			28			27		26			25
11													
12	31	32			33			34		35			36
13													

NOTE: Not more than 2 corners, all in the same town and range, may be recorded on this certificate.

A. Description of original monument and accessories and/or subsequent restoration:

November 2, 1837, Abner E. VanNess, Deputy Surveyor GLO "Set Post Cor. to Sect. 4, 5, 8&9"
24" Pine S10°W 6 Links (3.96') 8" Beech East 11 Links (7.26')

April 4, 1907, Lyman W. June, County Surveyor (Record Book 1, P152) (FB 9, Pgs 32-33) "No Witnesses Given"
Survey in SW 1/4 Section 4 gives 20.62 Chains (1360.92') West of SE Corner, SW1/4, SW1/4

October 25, 1990, James J. Keller, RLS #10693 (FB 107-W P81) "Found 2"x2"x1/4" Angle 4" Deep"
Set 30d NE Sd. 16" Ash N08°W 95.70' Set 30d SW Sd. 12" Oak S64°E 20.28'
Set 30d SE Sd. 12" Oak S25°W 81.80' USC & GS BM E1 955 N42°W 30.96'

March 21, 1994, William Tingley, RLS #30104 (Unrecorded Survey #94025) "Found Angle Iron"
Center of Riser Box N45°W 39.88' Set PK & Tag S Side 10" Maple S80°E 20.40'
Set PK & Tag W Side 6" Oak S35°E 68.70' Set PK & Tag E side 12" Oak S30°W 81.71'

August 12, 1998, Joseph C. Kapelczak, RLS #24598 (L12 Pgs 427, 428, 429)
"NE Corner, Section 7, T13N, R10W, Aetna Twp, Mecosta County, Michigan" (No Witnesses Given)


B. Description of corner evidence found and/or method applied in restoring or reestablishing corner:

September 17, 1998, James J. Keller, RLS #10693 (FB 138-W P62) "Found 2"x2"x1/4" Angle 2-1/2" Deep"
USC & GS BM N41°W 31.06'
FND PK Nail & Washer #30104 SW Sd. 13" Oak S55°E 20.40'
FND PK Nail & Washer #30104 W Sd. 7" Oak S13-1/2°E 68.65'
FND PK Nail & Washer #30104 SE Sd. 13" Oak S34°W 81.67'

C. Description of monument for corner and accessories established to perpetuate locating the position of the corner:

Accepted 2"x2"x1/4" Pointed Angle 17-1/2" Long with 5"x8"x12" Stone on SW Sd and Set Remonumentation Monument as a Careful and Faithful Perpetuation of the Position of the Original Corner.

USC & GS BM N41°W 31.06'
Set 60d & Tag Above PK Nail and Washer #30104 SW Sd 13" Oak S55°E 20.40'
Set 60d & Tag Above PK Nail and Washer #30104 W Sd 7" Oak S13-1/2°E 68.65'
Set 60d & Tag Above PK Nail and Washer #30104 SE Sd 13" Oak S34°W 81.67'

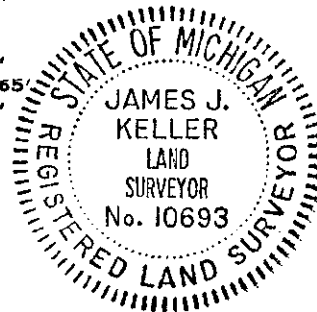

Signed by *James J. Keller*

Date October 28, 1998

Surveyor's Michigan License No. 10693

FORM APPROVED BY MICHIGAN STATE BOARD OF LAND SURVEYORS, JAN. 28, 1971
REVISED MAY 14, 1975
REVISED JAN. 1983
ADAPTED FOR WORD PROCESSING MARCH, 1993

APPROVED BY MECOSTA CO. PEER GROUP
IN ACCORDANCE WITH P.A. 245 OF 1990

James J. Knapp
CHAIRMAN
OCT 9 1998

SURVEY &
REMONUMENTATION

MAR 03 1999

SECTION

OCT 27 - 1998

JJK LJH TMB

