

MECOSTA COUNTY REMONUMENTATION PROGRAM

STATE OF MICHIGAN
COUNTY OF MECOSTA
RECEIVED FOR RECORD

CORNER APPROVED BY PEER GROUP ON November 14, 1997

LAND CORNER RECORDATION CERTIFICATE

Filing Requirement of Act 74, Mich. P.A. 1970z

'97 DEC 22 A8:42

For corners in

Mecosta
(County)

Located In:

Aetna Township

Corner Code #

James Brown
REGISTER OF DEEDS

1. Public Land Survey SEC 4 T13N R10W F-1
 T R
 T R
 T R
 2. Property Controlling S T R
 in Section S T R
 3. Miscellaneous S T R
 Property in Sec. S T R

Register of Deeds Stamp & File Number

4. Lot No. _____, Recorded Plat _____
 5. Private Claims _____

I, James J. Keller, in a field survey on August 19 97, do hereby certify that under requirements of P.A. 74, Michigan P.A. of 1970, the corner points mentioned in lines 1 and 2 above were in conformance with regulations and rules therefore as required in the current manual of survey instructions of the United States Department of the Interior, Bureau of Land Management or by a decree of a Court of Law and/or that the corner points mentioned in lines 3, 4 and 5 above were in conformance with the rules of the Michigan Board of Land Surveyors or by a Decree of a Court of Law; established, re-established, monumented, re-monumented, recovered, found as expressed below:

	A	B	C	D	E	F	G	H	I	J	K	L	M
1													
2	6	5				4			3			2	1
3													
4	7	8				9			10			11	12
5													
6	18	17				16			15			14	13
7													
8	19	20				21			22			23	24
9													
10	30	29				28			27			26	25
11													
12	31	32				33			34			35	36
13													

NOTE: Not more than 4 corners, all in the same town and range, may be recorded on this certificate.

A. Description of original monument and accessories and/or subsequent restoration:

Corner Not Set by G.L.O.

B. Description of corner evidence found and/or method applied in restoring or reestablishing corner:

November 13, 1997, James J. Keller, R.L.S. #10693, Searched for but did not find any direct evidence of the Corner and considered it as Lost.

Set 1/2" Rebar on Line between G-13 and E-13 and midway between G-1 and E-1

SURVEY & REMONUMENTATION


FEB 26 1998

SECTION

C. Description of monument for corner and accessories established to perpetuate locating the position of the corner:

Accepted and set Remonumentation Monument as a careful and faithful reestablishment of the position of the Original Corner.

Set 60d and Tag SE side 16" Oak N34°E 60.25'
 Set 60d and Tag S side 10" Oak N84°E 46.18'
 Set 60d and Tag SW side 8" Oak S51°E 79.32'
 Set 60d and Tag W side 8" White Pine S12°E 65.68'
 S1/4 Cor 33-14-10 (Remon Mon) N89°37'12"W 95.88'

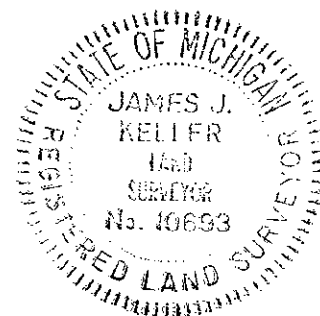

Signed by James J. Keller Date December 2, 1997

Surveyor's Michigan License No. 10693

FORM APPROVED BY MICHIGAN STATE BOARD OF LAND SURVEYORS, JAN. 26, 1971
 REVISED MAY 14, 1975
 REVISED JAN. 1983
 ADAPTED FOR WORD PROCESSING MARCH 1993

APPROVED BY MECOSTA CO. PEER GROUP
 IN ACCORDANCE WITH P.A. 345 of 1990


James S. Knapp
 CHAIRMAN
 DATE NOV. 17, 1997

LIBER 100 PAGE 333

Dec 2, 1997

LJH

as set

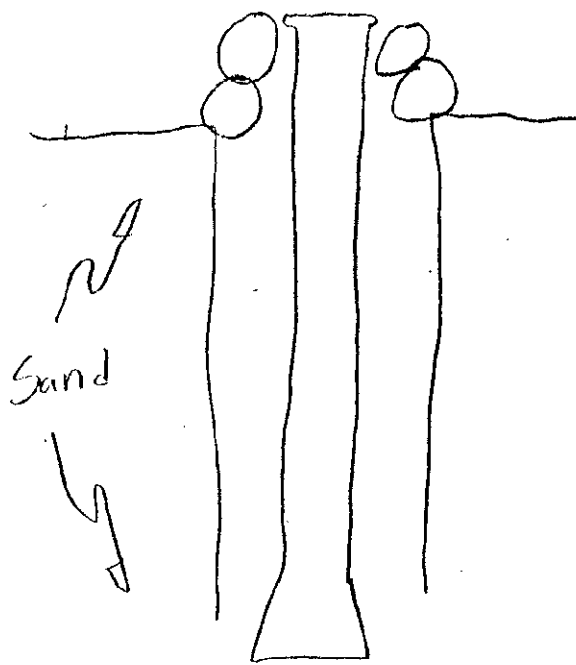

Set mon 6"
above Ground
with Small stones
around the top of
The mon

SURVEY &
REMONUMENTATION

FEB 26 1998

SECTION