

**SURVEY &
REMONUMENTATION**

APR 04 1996

LAND CORNER RECORDATION CERTIFICATE

Filing Requirement of Act 74, Mich. P.A. 1970

COMMISSION

For corners in

Mecosta
(County)

Located In:

Aetna Township

Corner Code #

- | | | |
|------------------------------------|-------------------------|------------------------|
| 1. Public Land Survey | Sec 16/T 13N R 10 | <u>E-7, 1/4 Corner</u> |
| | 21T _____ R _____ | _____ |
| | T _____ R _____ | _____ |
| | T _____ R _____ | _____ |
| 2. Property Controlling in Section | S _____ T _____ R _____ | _____ |
| | S _____ T _____ R _____ | _____ |
| 3. Miscellaneous Property in Sec. | S _____ T _____ R _____ | _____ |
| | S _____ T _____ R _____ | _____ |

STATE OF MICHIGAN
COUNTY OF MECOSTA
RECEIVED FOR RECORD

'95 DEC 29 A8:47

Joann Brown
REGISTER OF DEEDS

Register of Deeds Stamp & File Number

4. Lot No. _____, Recorded Plat _____
5. Private Claims _____

I, William Tingley a field survey on July 25, 1995, do hereby certify that under requirements of P.A. 74, Michigan P.A. of 1970, the corner points mentioned in lines 1 and 2 above were in conformance with regulations and rules therefore as required in the current manual of survey instructions of the United States Department of the Interior, Bureau of Land Management or by a decree of a Court of Law and/or that the corner points mentioned in lines 3, 4 and 5 above were in conformance with the rules of the Michigan Board of Land Surveyors or by a Decree of a Court of Law; established, re-established, monumented, re-monumented, recovered, found as expressed below:

NOTE: Not more than 4 corners, all in the same town and range, may be recorded on this certificate.

A. Description of original monument and accessories and/or subsequent restoration:

1837, Abner Van Ness, GLO Notes

Set Quarter Post

1964, Carl Rosen, Michigan State Highway Department

Found Plow Point Buried

- | | | |
|------------|-------|------------|
| Power Pole | N17°E | 48.31 feet |
| Oak 23" | N50°E | 51.86 feet |
| Oak 17" | S70°E | 64.75 feet |
| Oak 15" | S08°E | 26.29 feet |

1976, Gerald Grey, #17741

Found Steel Bar

- | | | |
|------------|-------|------------|
| Cherry 8" | N45°W | 40.23 feet |
| Cherry 10" | S45°W | 38.42 feet |
| Oak 20" | S05°E | 26.55 feet |

1991 James Keller

Found Plow Point 5" deep

- | | | |
|---------------------------|-------|------------|
| Found Nail in Power Pole | N16°E | 48.27 feet |
| Set Nail in 16" White Oak | S01°W | 26.28 feet |
| Set Nail in 10" White Oak | S53°W | 38.52 feet |
| Telephone Box | N12°W | 27.79 feet |

B. Description of corner evidence found and/or method applied in restoring or reestablishing corner:

Found Plow Point (0.15 x 1.75 feet x 3.3 feet "J" Shaped Iron)

- | | | |
|--------------------------------|-------|------------|
| Found Nail & Tag in Power Pole | N16°E | 48.24 feet |
| Found nail in 30" Twin oak | N50°E | 51.87 feet |
| Found Spike in 20" Twin Oak | S52°E | 63.57 feet |
| Found Nail in 21" Oak | South | 26.02 feet |

C. Description of monument for corner and accessories established to perpetuate locating the position of the corner:

Set Remonumentation Corner


Found Plow Point (0.15 x 1.75 feet x 3.3 feet "J" Shaped Iron)

- | | | |
|--------------------------------|-------|------------|
| Found Nail & Tag in Power Pole | N16°E | 48.24 feet |
| Found nail in 30" Twin oak | N50°E | 51.87 feet |
| Found Spike in 20" Twin Oak | S52°E | 63.57 feet |
| Found Nail in 21" Oak | South | 26.02 feet |

This corner is accepted as a careful and faithful perpetuation of the position of the original corner.

APPROVED BY MECOSTA CO. PEER GROUP
IN ACCORDANCE WITH P.A. 345 of 1990
James D. Knapp
CHAIRMAN
DATE July 27, 1995

	A	B	C	D	E	F	G	H	I	J	K	L	M
1													
2	6	5	4	3	2	1							
3													
4	7	8	9	10	11	12							
5													
6	18	17	16	15	14	13							
7													
8	19	20	21	22	23	24							
9													
10	30	29	28	27	26	25							
11													
12	31	32	33	34	35	36							
13													

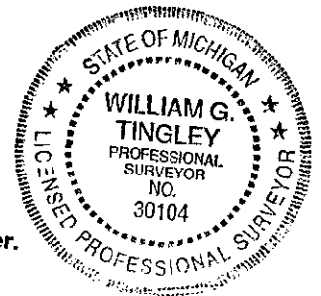

Signed by William G. Tingley Date 12-22, 1995
Surveyor's Michigan License No. 30104