

SURVEY & REMONUMENTATION

APR 04 1996

COMMISSION

LAND CORNER RECORDATION CERTIFICATE

Filing Requirement of Act 74, Mich. P.A. 1970

STATE OF MICHIGAN
COUNTY OF MECOSTA
RECEIVED FOR RECORD

For corners in Mecosta (County) Located In: Aetna Township Corner Code # F-9, 1/4 Corner

1. Public Land Survey Sec 21/T 13 N R 10 W
28 T R
T R
T R

2. Property Controlling in Section S T R
S T R

3. Miscellaneous Property in Sec. S T R
S T R

4. Lot No. _____ Recorded Plat _____

5. Private Claims _____

95 DEC 29 A8:47

James Brown
REGISTER OF DEEDS

Register of Deeds Stamp & File Number

I, William Tingley a field survey on July 25, 1995, do hereby certify that under requirements of P.A. 74, Michigan P.A. of 1970, the corner points mentioned in lines 1 and 2 above were in conformance with regulations and rules therefore as required in the current manual of survey instructions of the United States Department of the Interior, Bureau of Land Management or by a decree of a Court of Law and/or that the corner points mentioned in lines 3, 4 and 5 above were in conformance with the rules of the Michigan Board of Land Surveyors or by a Decree of a Court of Law; established, re-established, monumented, re-monumented, recovered, found as expressed below:

NOTE: Not more than 4 corners, all in the same town and range, may be recorded on this certificate.

A. Description of original monument and accessories and/or subsequent restoration:
1837, Abner VanNess, Deputy Surveyor, GLO Notes

Set Quarter Section Post
Pine 18" N46°E 10 links
Oak 12" N69°W 13 links

1895, L.W. June, County Surveyor
Pine Stump 20" N46°E 10 links (Old Bearing Tree)
Oak 12" N69°W 13 links (Old Bearing Tree)

December 1965, George Blass, Surveyor
1/2" Pipe in center of road approximately 40 feet East of old fence corner
Fence line West and North
White Oak 8" N61°W 26.60 feet
Clump of Maple S65°W 42.96 feet
Red Oak 7" N51°E 74.13 feet

1971, Patrick Salisbury #13594, LCRC, Liber 1 Page 32
Found Iron Fence Post protruding 3 feet out of ground 33 feet East of Center of gravel road
Spike in 8" Maple Clump S80°W 73.60 feet
Spike in 8" White Oak N75°W 58.40 feet
Spike in 10" Oak N30°E 54.90 feet

1977, Gerald Gray, Survey Liber 11, Page 779
White Post East 33.0 feet
Maple 10" S80°W 12.9 feet
Oak 8" N80°W 26.60 feet

1979, Gerald Gray, LCRC, Liber 1, Page 497
Found Iron Pipe
White Pine East 33.0 feet
10" Twin Maple S80°W 42.4 feet
8" Oak N80°W 26.6 feet

1980, Jack Pierson, Survey Liber 11, Page 34
Aspen 10" S31°E 17.75 feet
Oak 10" S82°W 15.83 feet
Oak 10" N40°W 20.50 feet

Continued on Next Page

B. Description of corner evidence found and/or method applied in restoring or reestablishing corner:
Found Boat Spike in centerline of road bed. Spike is 1/2" x 10-1/2"; set over 3/4" x 22" galvanized pipe which is 1.9 feet deep; nothing else below.

C. Description of monument for corner and accessories established to perpetuate locating the position of the corner:
Set Remonumentation Corner over Boat Spike over 3/4" Iron Pipe
Poplar 10" S32°E 17.75 feet
Oak 10" S82°W 15.85 feet
Oak 10" N40°W 20.50 feet
Maple 6" N40°E 23.40 feet

This corner is accepted as a careful and faithful perpetuation of the position of the original corner.

Signed by William G. Tingley Date 12-12 1995

Surveyor's Michigan License No. 30104

FORM APPROVED BY MICHIGAN STATE BOARD OF LAND SURVEYORS, JAN. 28, 91

REVISED MAY 14, 91


REVISED JAN., 91

ADAPTED FOR WORD PROCESSING MARCH, 91

	A	B	C	D	E	F	G	H	I	J	K	L	M
1													
2	6	5	4	3	2	1							
3													
4	7	8	9	10	11	12							
5													
6	18	17	16	15	14	13							
7													
8	19	20	21	22	23	24							
9													
10	30	29	28	27	26	25							
11													
12	31	32	33	34	35	36							
13													

APPROVED BY MECOSTA CO. PEER GROUP
IN ACCORDANCE WITH P.A. 345 of 1990

James M. Knapp
CHAIRMAN
DATE July 27, 1995

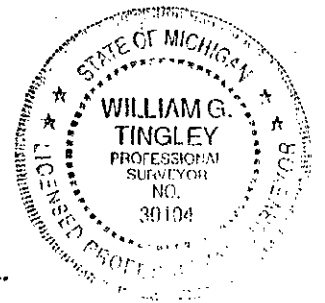

Continued from Front Page (F-9, 13-10)

1981, Jack Pierson, Survey SAL-041-80

3/4" Square Iron

Poplar	10"	S32°E	17.75 feet
Oak	10"	S82°W	15.85 feet
Oak	10"	N40°W	20.50 feet