

MECOSTA COUNTY REMONUMENTATION PROGRAM

CORNER APPROVED BY PEER GROUP ON November 14' 1997

STATE OF MICHIGAN
COUNTY OF MECOSTA
RECEIVED FOR RECORD

LAND CORNER RECORDATION CERTIFICATE

Filing Requirement of Act 74, Mich. P.A. 1970

'97 DEC 22 A8:42

For corners in
Mecosta
(County)

Located In:

Corner Code #

AETNA TOWNSHIP

1. Public Land Survey	SEC 3	T <u>13N</u> R <u>10W</u>	<u>G-1</u>
		T _____ R _____	_____
		T _____ R _____	_____
		T _____ R _____	_____
2. Property Controlling in Section	S _____	T _____ R _____	_____
	S _____	T _____ R _____	_____
3. Miscellaneous Property in Sec.	S _____	T _____ R _____	_____
	S _____	T _____ R _____	_____

James Brown
REGISTER OF DEEDS

Register of Deeds Stamp & File Number

4. Lot No. _____, Recorded Plat _____
5. Private Claims _____

1	A	B	C	D	E	F	G	H	I	J	K	L	M
2		6	5	4	3	2	1						
3													
4		7	8	9	10	11	12						
5													
6		18	17	16	15	14	13						
7													
8		19	20	21	22	23	24						
9													
10		30	29	28	27	26	25						
11													
12		31	32	33	34	35	36						
13													

I, James J. Keller, in a field survey on July-October 19 97, do hereby certify that under requirements of P.A. 74, Michigan P.A. of 1970, the corner points mentioned in lines 1 and 2 above were in conformance with regulations and rules therefore as required in the current manual of survey instructions of the United States Department of the Interior, Bureau of Land Management or by a decree of a Court of Law and/or that the corner points mentioned in lines 3, 4 and 5 above were in conformance with the rules of the Michigan Board of Land Surveyors or by a Decree of a Court of Law; established, re-established, monumented, re-monumented, recovered, found as expressed below:

NOTE: Not more than 4 corners, all in the same town and range, may be recorded on this certificate.

A. Description of original monument and accessories and/or subsequent restoration:

October 28, 1837, Abner E. VanNess, Deputy Surveyor G.L.O. "North between Sect. 3 & 4 intersected N. Boundary 233 Links (153.78') East of Post - Set Post Cor to Sect. 3 & 4" (Field Book 931, P33)
12" Beech S21°E 26 Links (17.16') 6" Beech S03°W 32 Links (21.12')

March 23-24-25-26, 1896, Lyman W. June, Mecosta County Surveyor "Stake"
10" Beech Stump S03°W 32 Links (21.12) = O.B.T. South 20.91 Chains (1380.06') King Bolt for Stake

May 28, 1910, Lyman W. June, Mecosta County Surveyor, indicates on sketch Corner is 2.33 Chains (153.78') East of S.E Corner Sec. 33 T14N, R10W

November 28, 1914, Walter Willits, Mecosta County Surveyor, Witnessed N 1/8 Corner Sections 3 & 4 at 2710'
8" White Oak S17°E 57' 10" Black Oak N16°W 64' 4" Maple N22°E 41.5'

B. Description of corner evidence found and/or method applied in restoring or reestablishing corner:

October 9, 1997 James J. Keller RLS # 10693 Searched for Corner; No Direct Evidence Found. Considered Corner Obliterated. Set 1/2" Rebar on Line I-13, H-13 and at Double Distance I-1, H-1 as June, 1896 Indicated (Proportioned)

C. Description of monument for corner and accessories established to perpetuate locating the position of the corner:


Accepted and set Remonumentation Monument as a Careful and Faithful Reestablishment of the position of the original corner.

Set 60d and Tag NE side Twin 8"-16" Maple N40°W 21.88'
Set 60d and Tag S side 5" Maple N78°E 14.49'
Set 60d and Tag W side 5" Oak Corner Post S05°W 34.83'
Set 60d and Tag N side 30" Maple S75°W 13.79'

SURVEY & REMONUMENTATION

FEB 26 1998

SECTION

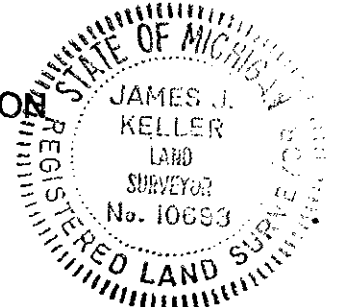

Signed by James J. Keller
Surveyor's Michigan License No. 10693

Date December 2, 1997

FORM APPROVED BY MICHIGAN STATE BOARD OF LAND SURVEYORS, JAN. 28, 1974
REVISED MAY 14, 1974
REVISED JAN. 1975
ADAPTED FOR WORD PROCESSING MARCH, 1975


APPROVED BY MECOSTA CO. PEER GROUP
IN ACCORDANCE WITH P.A. 74, 1970

James J. Keller
CHAIRMAN
DATE Nov. 14, 1997

Dec 2, 1997

LJH

as set

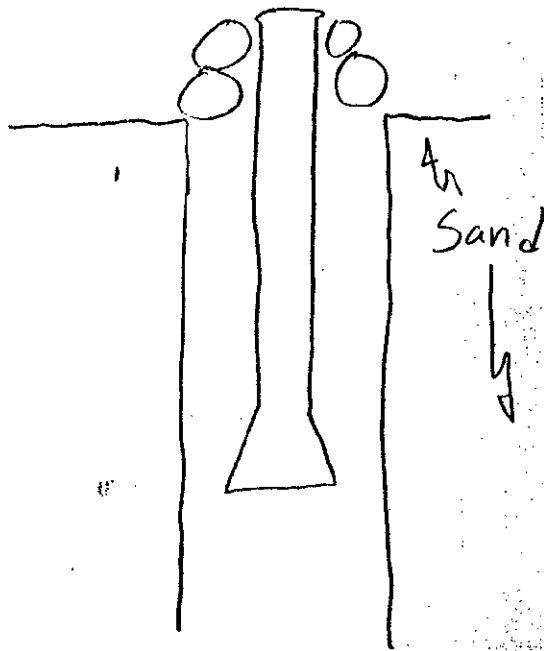

set mon 6"
above ground
with small stones
around top of mon

SURVEY &
REMONUMENTATION

FEB 26 1998

SECTION