

OCT 24 1999

MECOSTA COUNTY REMONUMENTATION PROGRAM

CORNER APPROVED BY PEER GROUP ON August 13, 1999

SECTION _____

LAND CORNER RECORDATION CERTIFICATE

Filing Requirement of Act 74, Mich. P.A. 1970

STATE OF MICHIGAN
COUNTY OF MECOSTA
RECEIVED FOR RECORD

For corners in Mecosta (County)	Located In:	Corner Code #
	Aetna Twp.	
1. Public Land Survey	SEC 10 T 13N R 10W	G-4
	T _____ R _____	_____
	T _____ R _____	_____
	T _____ R _____	_____
2. Property Controlling in Section	S _____ T _____ R _____	_____
	S _____ T _____ R _____	_____
3. Miscellaneous Property in Sec.	S _____ T _____ R _____	_____
	S _____ T _____ R _____	_____
4. Lot No. _____, Recorded Plat _____		
5. Private Claims _____		

'99 OCT -8 P3:05

Joann Brown
REGISTER OF DEEDS

Register of Deeds Stamp & File Number

I, James J. Keller, in a field survey on July 20, 1999, do hereby certify that under requirements of P.A. 74, Michigan P.A. of 1970, the corner points mentioned in lines 1 and 2 above were in conformance with regulations and rules therefore as required in the current manual of survey instructions of the United States Department of the Interior, Bureau of Land Management or by a decree of a Court of Law and/or that the corner points mentioned in lines 3, 4 and 5 above were in conformance with the rules of the Michigan Board of Land Surveyors or by a Decree of a Court of Law; established, re-established, monumented, re-monumented, recovered, found as expressed below:

	A	B	C	D	E	F	G	H	I	J	K	L	M
1													
2	6	5	4	3	2	1							
3													
4	7	8	9	10	11	12							
5													
6	18	17	16	15	14	13							
7													
8	19	20	21	22	23	24							
9													
10	30	29	28	27	26	25							
11													
12	31	32	33	34	35	36							
13													

NOTE: Not more than 2 corners, all in the same town and range, may be recorded on this certificate.

A. Description of original monument and accessories and/or subsequent restoration:

October 26, 1837, Abner E. Van Ness, Deputy Surveyor GLO "Set Qr Sec Post"
8" Beech S20°W 12 Links (7.92') 10" Sugar N33°E 16 Links (10.56')

November 24-28, 1903, Don E. Roben, County Surveyor, Mecosta County Road Commission (Field Book 6 P54-55) "Stake in Crossway O.B.T."

December 12, 1975, Douglas W. Booth, RLS #7966, MSHD Surveyor (LCRC L1 P236) "Found old Buggie Spring & Wood Stake.
Replaced with 3/8" Iron 18" Long"
8" Cherry S40°E 31.21' 14" Oak S45°W 36.50' 14" W. Birch N62°W 45.83'

September 7, 1978, Gerald J. Gray, RLS #17741 (Survey L10 P624, 615) "Found 3/8" Iron Rod"
8" Cherry S40°E 31.21' 14" Oak S45°W 36.50' 14" W. Birch N62°W 45.83'

August 14, 1979, Gerald J. Gray, RLS #17741 (LCRC L1 P498) "Found 3/8" Iron Rod"
8" Cherry S40°E 31.21' 14" Oak S45°W 36.50' 14" W. Birch N62°W 45.83'

August 5, 1997, James J. Keller, RLS #10693 (FB140-W P39-40) "Found 3/4" Ø Iron." Not Witnessed.

B. Description of corner evidence found and/or method applied in restoring or reestablishing corner:

July 20, 1999, James J. Keller, RLS #10693 (FB138-W P86) "Found 3/4" Iron 3" deep"
Set 60d SE sd 6" Willow N20°E 64.75'
Set 60d SE sd 18" Oak S45°W 36.00'
Set 60d E sd 8" Basswood S03°E 23.79'
Set 60d SW sd 10" Maple S55°E 24.80'
Face of Dead Cherry (MSHD Called in 1975) S40°E 30.95'


APPROVED BY MECOSTA CO. PEER GROUP
IN ACCORDANCE WITH P.A. 345 of 1990

James J. Knapp
DATE Aug. 13, 1999

C. Description of monument for corner and accessories established to perpetuate locating the position of the corner:

Accepted 3/4" Iron as a careful and faithful perpetuation of the position of the original corner and replaced with Remonumentation Monument

Found 60d and set tag SE sd 6" Willow N20°E 64.80'
Found 60d and set tag SE sd 18" Oak S45°W 36.00'
Found 60d and set tag E sd 8" Basswood S03°E 23.79'
Found 60d and set tag SW sd 10" Maple S55°E 24.80'
Face of Dead Cherry (MSHD Called in 1975) S40°E 30.94'

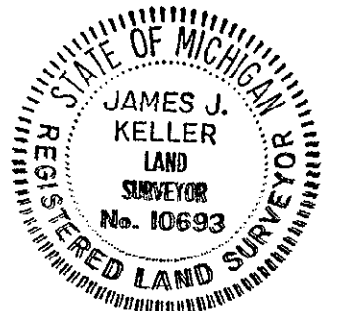

Signed by *James J. Keller*
Surveyor's Michigan License No. 10693


Date September 29, 1999

OCT 28 1999

SECTION

SEPT - 27 - 1999

LJH CH

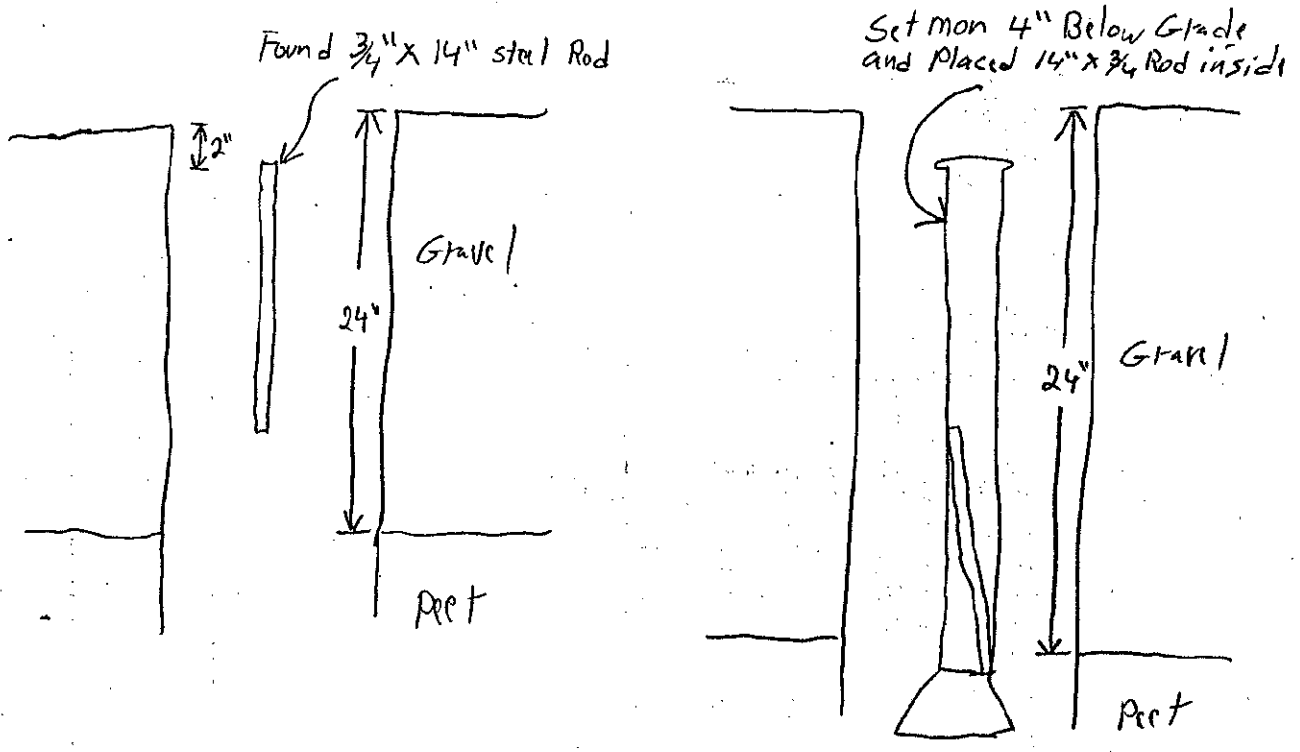

as Found

as Set