

**MECOSTA COUNTY REMONUMENTATION PROGRAM**

OCT 23 1999

CORNER APPROVED BY PEER GROUP ON August 13, 1999

**LAND CORNER RECORDATION CERTIFICATE**

STATE OF MICHIGAN  
COUNTY OF MECOSTA  
RECEIVED FOR RECORD

SECTION

Filing Requirement of Act 74, Mich. P.A. 1970

'99 OCT -8 P3:04

For corners in	Located In:	Corner Code #
Mecosta (County)	Aetna Twp.	
1. Public Land Survey	SEC 10 T 13N R 10W	H-3
	T R	
	T R	
	T R	
2. Property Controlling in Section	S T R	
	S T R	
3. Miscellaneous Property in Sec.	S T R	
	S T R	

*Joann Brown*  
REGISTER OF DEEDS

Register of Deeds Stamp & File Number

4. Lot No. \_\_\_\_\_ Recorded Plat \_\_\_\_\_  
5. Private Claims \_\_\_\_\_

	A	B	C	D	E	F	G	H	I	J	K	L	M
1													
2	6	5	4	3	2	1							
3													
4	7	8	9	10	11	12							
5													
6	18	17	16	15	14	13							
7													
8	19	20	21	22	23	24							
9													
10	30	29	28	27	26	25							
11													
12	31	32	33	34	35	36							
13													

I, James J. Keller, in a field survey on July 20, 19 99, do hereby certify that under requirements of P.A. 74, Michigan P.A. of 1970, the corner points mentioned in lines 1 and 2 above were in conformance with regulations and rules therefore as required in the current manual of survey instructions of the United States Department of the Interior, Bureau of Land Management or by a decree of a Court of Law and/or that the corner points mentioned in lines 3, 4 and 5 above were in conformance with the rules of the Michigan Board of Land Surveyors or by a Decree of a Court of Law; established, re-established, monumented, re-monumented, recovered, found as expressed below:

**NOTE: Not more than 2 corners, all in the same town and range, may be recorded on this certificate.**

**A. Description of original monument and accessories and/or subsequent restoration:**

October 28, 1837, Abner E. Van Ness, GLO Deputy Surveyor "Set Or Sec Post"  
8" Beech S20°W 12 Links (7.92') 10" Sugar N33°E 16 Links (10.56')

March 23, 24, 25, 26, 1898, Lyman W. June, County Surveyor (Field Book 1 P146-151) (Record Book 1 P13) "Stone & Scrap"  
10" B. Oak N54°W 56 Links (36.96') 12" Elm S55°W 57 Links (37.62')

May 1925, Mecosta County Road Survey Notes "Junes witnesses (stone & scrap)"  
B. Oak N54°W 56 links (36.96') 12" Elm S55°W 57 links (37.62')

December 12, 1975, Douglas W. Hooth, RLS #7966, MSRD Surveyor (LCRC L1 P237) "Found Plow Point in Nest of Stones 6ft Below West Lane of North & South Rd. from 1928 Mecosta County Road Witnesses. Raised with 1/2" Iron Pipe"  
12" Maple N76°E 40.67' 10" Basswood S65°W 27.68'  
8" Basswood S37°W 39.13' Face of rd. sign post S56°E 36.35'

**B. Description of corner evidence found and/or method applied in restoring or reestablishing corner:**

July 20, 1999, James J. Keller, RLS #10693 (FB138-W P88) "Found 1/2" IP 6" Below Grade 4' west of C/L of 205th Ave & 7' South of C/L 5 mile Rd"  
Found 60d W sd 8" Apple N13°E 127.58'  
Found 60d NE sd 10" Elm N20°W 36.04'  
Found 60d N sd 8" Elm N78°W 23.08'  
Set 60d NW sd 6" Ash S30°W 23.20'  
Set 60d SW sd 6" Elm S20°E 84.07'

APPROVED BY MECOSTA CO. PEER GROUP  
IN ACCORDANCE WITH P.A. 345 of 1990

*James M. Knapp*  
CLERK  
DATE Aug. 13, 1999

**C. Description of monument for corner and accessories established to perpetuate locating the position of the corner:**

Accepted 1/2" IP as a careful and faithful perpetuation of the original corner and replaced with Remonumentation Monument.

- Found 60d and set tag W sd 8" Apple N13°E 127.58'
- Found 60d and set tag NE sd 10" Elm N20°W 36.04'
- Found 60d and set tag N sd 8" Elm N78°W 23.08'
- Found 60d and set tag NW sd 6" Ash S30°W 23.20'
- Found 60d and set tag SW sd 6" Elm S20°E 84.07'



Signed by *James J. Keller*  
Surveyor's Michigan License No. 10693


Date September 29, 1999

OCT 24 1999

SECTION

Sept - 27 - 1999

LJH CH

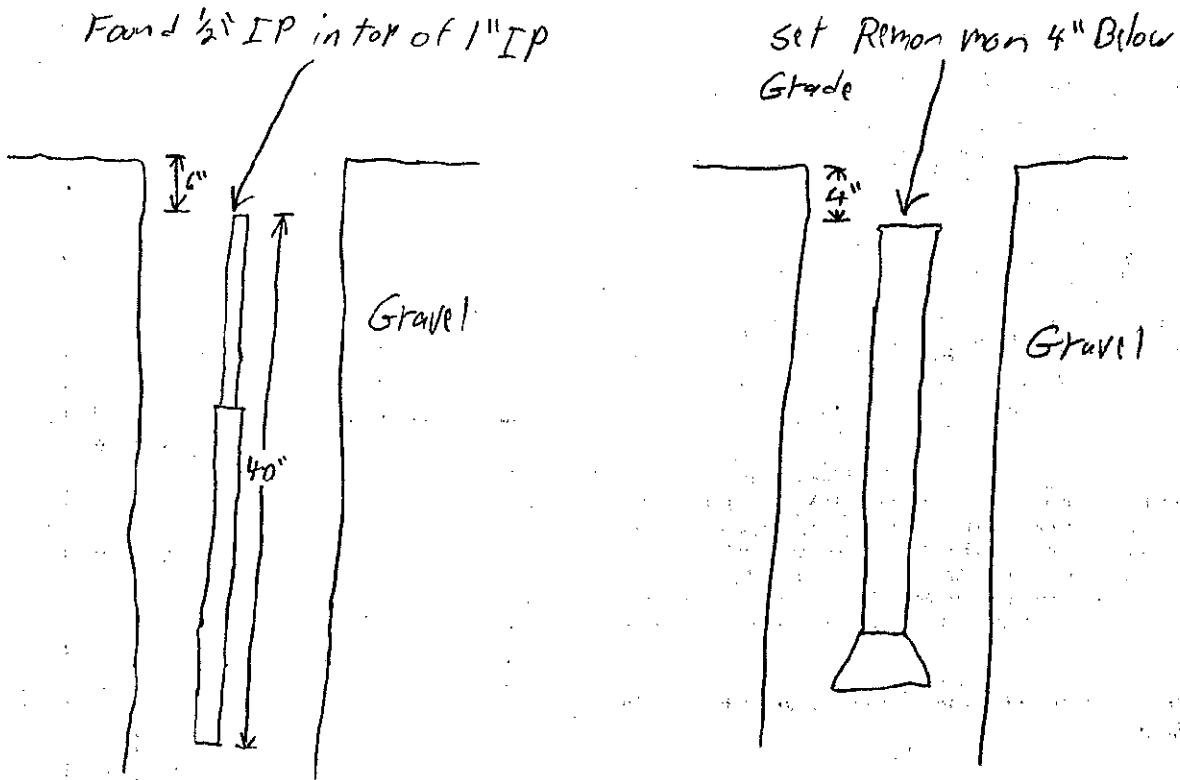

as found

as set