

SURVEY & MONUMENTAL MECOSTA COUNTY REMONUMENTATION PROGRAM

OCT 23 1999

CORNER APPROVED BY PEER GROUP ON August 13, 1999

LAND CORNER RECORDATION CERTIFICATE

Filing Requirement of Act 74, Mich. P.A. 1970

STATE OF MICHIGAN
COUNTY OF MECOSTA
RECEIVED FOR RECORD

SECTION

For corners in
Mecosta
(County)

Located In:

Corner Code #

Aetna Twp.

1. Public Land Survey	SEC 10	T 13	R 10	H-5
		T	R	
		T	R	
		T	R	
2. Property Controlling in Section	S	T	R	
	S	T	R	
3. Miscellaneous Property in Sec.	S	T	R	
	S	T	R	

'99 OCT -8 P3:04

Joan Brown
REGISTER OF DEEDS

Register of Deeds Stamp & File Number

4. Lot No. _____, Recorded Plat _____
5. Private Claims _____

I, James J. Keller, in a field survey on July 7, 19 99, do hereby certify that under requirements of P.A. 74, Michigan P.A. of 1970, the corner points mentioned in lines 1 and 2 above were in conformance with regulations and rules therefore as required in the current manual of survey instructions of the United States Department of the Interior, Bureau of Land Management or by a decree of a Court of Law and/or that the corner points mentioned in lines 3, 4 and 5 above were in conformance with the rules of the Michigan Board of Land Surveyors or by a Decree of a Court of Law, established, re-established, monumented, re-monumented, recovered, found as expressed below.

NOTE: Not more than 2 corners, all in the same town and range, may be recorded on this certificate.

A. Description of original monument and accessories and/or subsequent restoration:

- October 27, 1937, Abner E. Van Ness, GLO Deputy Surveyor "Set Or Sec Post"
10" Pine N61°E 15 Links (9.90') 20" Pine S08°E 14 Links (9.24')
- August 1919, H.A. Freeman, County Surveyor (Record Book 1 P195)
14" Maple N31°E 46'9" T.P. N59°E 36'9" 15" Elm S55-1/2°E 89-1/2'
- July 9, 1964, Carl F. Roser, RLS #12028, MSHD Surveyor (LCRC L1 P37) "Found 1/2" X 3" Iron Bar buried 10"
26" Maple N30°E 80.61' SE Cor Conc. Flag Pole Base N63°E 72.71' 25" Elm S13°E 115.65'
- April 18, 1978, Duane F. Wood, RLS #24625 (Survey L10 P526-529) "Found 1" Steel Bolt"
24" Maple N45°E 47.3' P. Pole N10°W 170.4' P. Pole S15°W 160.1'
- June 27, 1991, James J. Keller, RLS #10693 (FB 107-W P119) "Found 1-1/4" Round Iron 4" deep"
Stop Sign N10°W 59.41' Fnd MSHD tag SE sd 21" Maple N28°E 80.63'
Fnd 40d SE sd 30" Maple N48°E 47.35' Stop Sign S16°E 52.44'

B. Description of corner evidence found and/or method applied in restoring or reestablishing corner:

- July 7, 1999, James J. Keller, RLS #10693 (FB 138-W P88) "4 Mile Road Recently Repaved. Found 1-1/4" Iron 13" deep from Roser Witnesses of 1964 Using SE Corner of Flag Pole Concrete 72.71' and MSHD Tag in 30" Maple 80.61'
- July 7, 1999, James J. Keller, RLS #10693 (Survey L12 P575-576) "Found 1-1/4" Iron 13" Deep"
Found 60d E side Distribution Pole N03°W 170.49'
Found MSHD Tag E sd 30" Maple N30°E 80.68'
SW Corner Foundation Green Sunday School Building N48°E 113.93'
SE Corner Conc. Flag Pole Foundation N66°E 72.79'
Found PK Nail W side Distribution Pole S14°W 160.03'

C. Description of monument for corner and accessories established to perpetuate locating the position of the corner:

Accepted 1-1/4" Iron as best Evidence of the Original Corner. Set Remonumentation Monument in Box over Iron as a Careful and Faithful Perpetuation of the Original Corner.
Set 60d and Tag E side Distribution Pole N03°W 170.49'
Found MSHD Tag and Set 60d and Tag above 30" Maple N30°E 80.68'
SW Corner Foundation Green Sunday School Building N48°E 113.93'
SE Corner Conc. Flag Pole Foundation N66°E 72.79'
Found PK Nail and set tag W side Distribution Pole S14°W 160.03'

APPROVED BY MECOSTA CO. PEER GROUP
IN ACCORDANCE WITH P.A. 74 of 1990

James S. Knapp
CHAIRMAN
DATE Aug. 13, 1999



Signed by *James J. Keller* Date September 29, 1999
Surveyor's Michigan License No. 10693


FORM APPROVED BY MICHIGAN STATE BOARD OF LAND SURVEYORS, JAN. 28, 1971
REVISED MAY 14, 1975
REVISED JAN., 1983
ADAPTED FOR WORD PROCESSING MARCH, 1983

OCT 26 1999


SECTION

July 19, 1999

JJK LJH CH

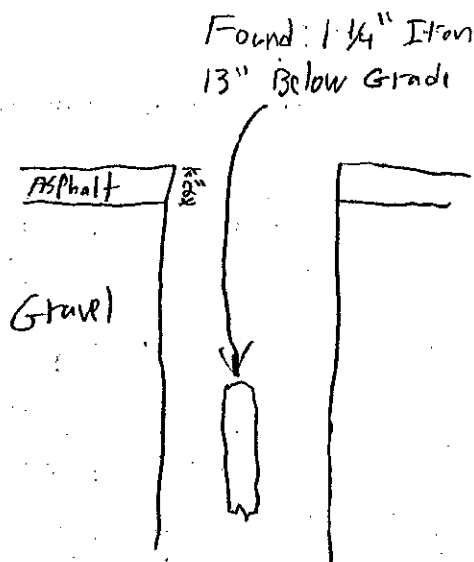

as Found

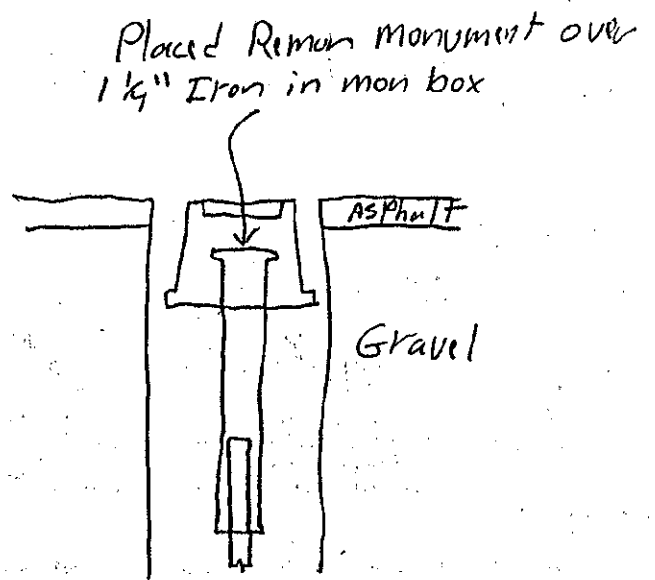

as Set