

OCT 8 1999

MECOSTA COUNTY REMONUMENTATION PROGRAM  
CORNER APPROVED BY PEER GROUP ON August 13, 1999

SECTION

LAND CORNER RECORDATION CERTIFICATE  
Filing Requirement of Act 74, Mich. P.A. 1970

STATE OF MICHIGAN  
COUNTY OF MECOSTA  
RECEIVED FOR RECORD

For corners in Mecosta (County)	Located In: Aetna Twp.	Corner Code #
1. Public Land Survey	SEC 10 T 13N R 10W	I-4
	T R	
	T R	
	T R	
2. Property Controlling in Section	S T R	
	S T R	
3. Miscellaneous Property in Sec.	S T R	
	S T R	

'99 OCT -8 P3:05

*Joanne Brown*  
REGISTER OF DEEDS

Register of Deeds Stamp & File Number

4. Lot No. \_\_\_\_\_, Recorded Plat \_\_\_\_\_  
5. Private Claims \_\_\_\_\_

	A	B	C	D	E	F	G	H	I	J	K	L	M
1													
2	6	5	4	3	2	1							
3													
4	7	8	9	10	11	12							
5													
6	18	17	16	15	14	13							
7													
8	19	20	21	22	23	24							
9													
10	30	29	28	27	26	25							
11													
12	31	32	33	34	35	36							
13													

I, James J. Keller, in a field survey on August 10, 1999, do hereby certify that under requirements of P.A. 74, Michigan P.A. of 1970, the corner points mentioned in lines 1 and 2 above were in conformance with regulations and rules therefore as required in the current manual of survey instructions of the United States Department of the Interior, Bureau of Land Management or by a decree of a Court of Law and/or that the corner points mentioned in lines 3, 4 and 5 above were in conformance with the rules of the Michigan Board of Land Surveyors or by a Decree of a Court of Law, established, re-established, monumented, re-monumented, recovered, found as expressed below:

NOTE: Not more than 2 corners, all in the same town and range, may be recorded on this certificate.

A. Description of original monument and accessories and/or subsequent restoration:

- October 26, 1837, Abner E. Van Ness, Deputy Surveyor GLO "Set Gr Sec Post"  
10" Maple N71°W 17 Links (11.22') 12" Maple S71°E 13 Links (8.58')
- December 12, 1975, Douglas W. Hooth, RLS #7966, MSHD Surveyor (LCRC L1 P242) "Found 1" X 2" Iron 4" Below Surface of Rd. and in line with Fence to the West."  
12" Maple S34°W 47.45' 28" Oak S09°E 109.15' 5" Maple N38°W 39.35'
- April 18, 1978, Duane F. Wood, RLS #24625 (Survey L10 P526-529) "Found 1" X 2" Iron"  
12" Maple S34°W 47.45' 28" Oak S09°E 109.15' 5" Maple N38°W 39.35'
- June 30, 1987, William G. Tingley, RLS #30104 (Survey L11 P209) "Found rebar C/L rd & West fence"  
12" Maple S34°W 47.45' 28" Oak S09°E 109.15' 5" Maple N38°W 39.35'

B. Description of corner evidence found and/or method applied in restoring or reestablishing corner:

August 10, 1999, James J. Keller, RLS #10693 (FB138-W P89) "Found 1" X 2" Iron 4" deep 2' E of C/L Rd."  
Set 60d N sd 14" Maple S88°W 48.78'  
Set 60d SE sd 8" Elm N40°E 44.40'  
Found Rebar and Cap #30104 & 1" Ø IP 2.5' High Alongside S86°E 32.93'  
Set 30d W sd 18" Oak Stump With Wire S11°E 82.39'  
Center of 28" Oak Stump S05°E 109.11'

C. Description of monument for corner and accessories established to perpetuate locating the position of the corner:

Accepted 1" X 2" iron as a careful and faithful perpetuation of the original corner and replaced with Remonumentation Monument.

- Found 60d and set tag N sd 14" Maple S88°W 48.78'
- Found 60d and set tag SE sd 8" Elm N40°E 44.40'
- Found Rebar and Cap #30104 & 1" Ø IP 2.5' High Alongside S86°E 32.93'
- Set 60d and tag W sd 18" Oak Stump With Wire S11°E 82.39'
- Center of 28" Oak Stump S05°E 109.11'

APPROVED BY MECOSTA CO. PEER GROUP  
IN ACCORDANCE WITH P.A. 74 of 1970

*James J. Knapp*  
DATE Aug. 13, 1999



Signed by James J. Keller Date September 29, 1999


Surveyor's Michigan License No. 10693

OCT 23 1999


SEPT - 27 - 1997

SECTION

LJH CH

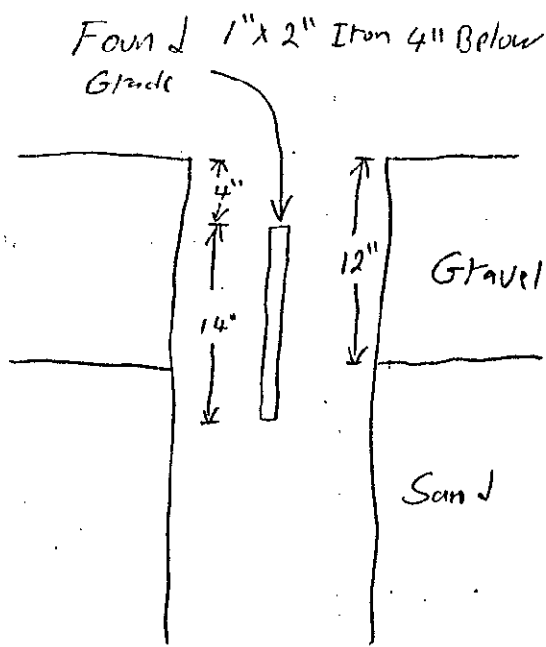

as Found

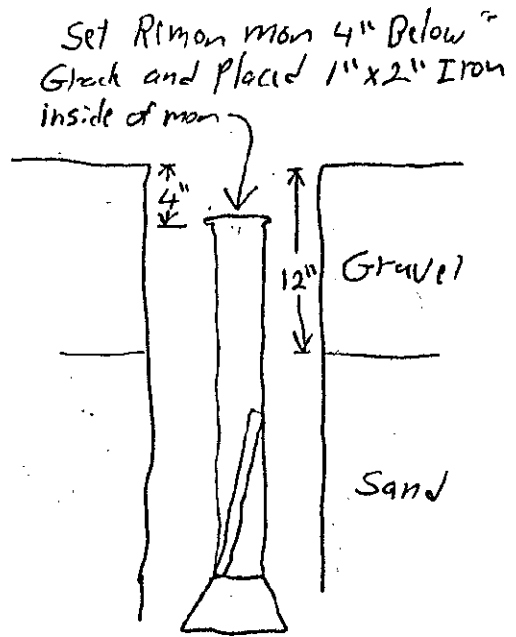

as Set