

**SURVEY &
REMONUMENTATION**

JUL 06 1998

MECOSTA COUNTY REMONUMENTATION PROGRAM

CORNER APPROVED BY PEER GROUP ON December 12, 1997

SECTION

LAND CORNER RECORDATION CERTIFICATE

Filing Requirement of Act 74, Mich. P.A. 1970

STATE OF MICHIGAN
COUNTY OF MECOSTA
RECEIVED FOR RECORD

For corners in

Mecosta
(County)

Located in:

Aetna Township

Corner Code #

'98 APR 10 A10:35

1. Public Land Survey	SEC 14 T13N R10W	I-5
	T R	
	T R	
	T R	
2. Property Controlling in Section	S T R	
	S T R	
3. Miscellaneous Property in Sec.	S T R	
	S T R	

Joann Brown
REGISTER OF DEEDS

Register of Deeds Stamp & File Number

4. Lot No. _____ Recorded Plat _____
5. Private Claims _____

I, James J. Keller, in a field survey on March-August 19 96 do hereby certify that under requirements of P.A. 74, Michigan P.A. of 1970, the corner points mentioned in lines 1 and 2 above were in conformance with regulations and rules therefore as required in the current manual of survey instructions of the United States Department of the Interior, Bureau of Land Management or by a decree of a Court of Law and/or that the corner points mentioned in lines 3, 4 and 5 above were in conformance with the rules of the Michigan Board of Land Surveyors or by a Decree of a Court of Law; established, re-established, monumented, re-monumented, recovered, found as expressed below:

	A	B	C	D	E	F	G	H	I	J	K	L	M
1													
2	6	5	4	3	2	1							
3													
4	7	8	9	10	11	12							
5													
6	18	17	16	15	14	13							
7													
8	19	20	21	22	23	24							
9													
10	30	29	28	27	26	25							
11													
12	31	32	33	34	35	36							
13													

NOTE: Not more than 2 corners, all in the same town and range, may be recorded on this certificate.

A. Description of original monument and accessories and/or subsequent restoration:

- October 23, 1837, Abner E. VanNess, Deputy Surveyor G.L.O. "Set Post Cor. to Sect. 10, 11, 14 & 15"
8" Beech S23°W 21 Links (13.86')
12" Beech S40°E 19 Links (12.54')
- 1975, MSHD (Found 9" Flat Iron Blade)
T. Pole N55°E 39.97' 11" Oak N35°W 73.60' 30" Oak S55°W 62.42'
- February 20, 1989, Duane F. Wood R.L.S. #24625 "Found 1/2" Steel Rod & Cap in Road Intersection"
4" Maple Az. 130° 56.95' 40" Maple Az. 238° 61.60'
10" Poplar Az. 328° 72.95' P. Pole Az. 55° 39.75'

B. Description of corner evidence found and/or method applied in restoring or reestablishing corner:


- March 19, 1996, James J. Keller R.L.S. #10693 Field Book #113W, Page 134 "Found 3/4" Rebar 5" deep in intersection 4 Mile Road and 200th Avenue"
Set 60d SW side 28" White Pine N60°W 133.58' Set 60d NE side 12" Popple N28°W 73.03'
Set 60d W side 28" White Oak S21°W 109.93' Set 60d S side 12" Elm S83°W 164.02'

APPROVED BY MECOSTA CO. PEER GROUP
IN ACCORDANCE WITH P.A. 343 of 1990

James J. Knapp
CHAIRMAN
DATE DEC. 12, 1997

C. Description of monument for corner and accessories established to perpetuate locating the position of the corner:

- Accepted Rebar and set Remonumentation Monument in Box as a careful and faithful perpetuation of the position of the Original Corner.
Found 60d and Tag SW side 28" White Pine N60°W 133.45'
Found 60d and Tag NE side 12" Popple N28°W 72.96'
Set Pk & Tag E side Transf. Pole S14°W 185.05'
Found 60d and Tag S side 12" Elm S82°W 163.92'

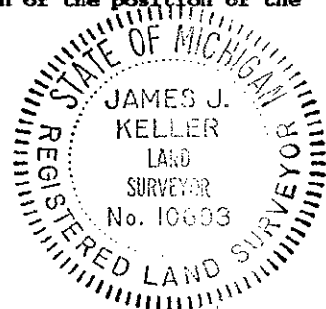

Signed by James J. Keller Date December 12, 1997

Surveyor's Michigan License No. 10693

FORM APPROVED BY MICHIGAN STATE BOARD OF LAND SURVEYORS, JAN. 28, 1971
REVISED MAY 14, 1975
REVISED JAN., 1983
ADAPTED FOR WORD PROCESSING MARCH, 1983

SURVEY &
RECONSTRUCTION

JUL 06 1998

SECTION

12-17-1997

LJH

AS Found

