

**SURVEY & REMONUMENTATION MECOSTA COUNTY REMONUMENTATION PROGRAM**

**CORNER APPROVED BY PEER GROUP ON November 13, 1998**

MAR 03 1999

**LAND CORNER RECORDATION CERTIFICATE**

**Filing Requirement of Act 74, Mich. P.A. 1970**

STATE OF MICHIGAN  
COUNTY OF MECOSTA  
RECEIVED FOR RECORD

**SECTION**

For corners in Mecosta (County)	Located In: Aetna Township	Corner Code # A-3
1. Public Land Survey	SEC 6 T 13N R 10W	
	T R	
	T R	
	T R	
2. Property Controlling in Section	S T R	
	S T R	
3. Miscellaneous Property in Sec.	S T R	
	S T R	

'98 DEC 28 A8:37

*James Brown*  
REGISTER OF DEEDS

Register of Deeds Stamp & File Number

4. Lot No. \_\_\_\_\_, Recorded Plat \_\_\_\_\_  
5. Private Claims \_\_\_\_\_

I, James J. Keller, in a field survey on October 24 19 98, do hereby certify that under requirements of P.A. 74, Michigan P.A. of 1970, the corner points mentioned in lines 1 and 2 above were in conformance with regulations and rules therefore as required in the current manual of survey instructions of the United States Department of the Interior, Bureau of Land Management or by a decree of a Court of Law and/or that the corner points mentioned in lines 3, 4 and 5 above were in conformance with the rules of the Michigan Board of Land Surveyors or by a Decree of a Court of Law, established, re-established, monumented, re-monumented, recovered, found as expressed below:

**NOTE: Not more than 2 corners, all in the same town and range, may be recorded on this certificate.**


**A. Description of original monument and accessories and/or subsequent restoration:**

- November 9, 1837, John Hodgson, Deputy Surveyor GLO, "Set Qr. Sec. Post"  
8" Beech N77°E 21 Links (13.86') 18" Maple S69°W 8 Links (5.28')
- December 13, 1926, Wm Fargo, Consumers Power Company Dwg #F-5608, "Accepted Stone and Glass. Set Std. Marker"  
36" Pine Stump N27°E 1.46 ch (96.36') 36" Pine Stump S46-1/2°E 44-1/2 Links (29.37')  
6" Apple S43-3/4°W 1.00-1/4 ch (66.17')
- June 22, 1938, M.D. Stitt, Consumers Power Company Dwg #HS-4598-G, Muskegon River File  
"SW Corner Section 6, CPCo Marker and White National Forest Post" (No Witnesses)
- April 12, 1968 USFS Book 21 Pg 131  
36" Pine Stump N27°E 1.46 Ch (96.36') Pine Stump S46-1/2°E 44.5 Links (29.37')  
6" Apple S43-3/4°W 1.00-1/4 Ch (66.17')
- September 1987, CPCo. "Fnd 2" Pipe Beside Painted Stone, 15' South of Road to East  
P. Pole W 43.79' 8" Pine N44°W 85.74'  
12" Pine N64°E 88.00' 36" Maple S80°E 90.22'
- October 30, 1991, James J. Keller, RLS #10693, (FB 107, P130), "Fnd 2" IP 2" Deep, Believed to be CPCo Std. Prop. Marker"  
Fnd Form Nail NW Sd 12" Red Pine N38°E 85.70' Fnd Form Nail SE Sd 15" Red Pine N60°E 78.95'  
Fnd Form Nail S Sd 36" Maple S77°E 90.20' Fnd Form Nail N Sd Dist. Pole S89°W 43.79'
- October 13, 1993, Norman L. Ochs, RLS #22439 (Unrecorded Survey #93283B) "Fnd 2" Pipe (CPCo Marker)"  
8" Red Pine N45°E 85.55' P. Pole W 43.75'  
6"-15" Maple S85°E 89.30' 16" Red Pine N60°E 79.00'
- December 15, 1994, Norman L. Ochs RLS #22439 (Vol.1 P106) Newaygo County Remonumentation Program  
"Accepted 2" Iron pipe with Consumers Power Co. cap as a substantial marker for the section corner and is accepted as a careful re-establishment of the original corner."  
P. Pole West 43.75' Spike in North side of pole #7 16" R. pine N60°E 79.00' Spike in North side of tree #8  
8" R. Pine N45°E 85.55' Spike in West side of tree # 10  
36" Maple S85°E Spike in North side of tree #11

**B. Description of corner evidence found and/or method applied in restoring or reestablishing corner:**

- October 24, 1998, James J. Keller, RLS #10693 (FB 138-W, D65) "Found 2" IP 2" Deep, No Cap"  
Set 60d SE Sd 10" Red Pine N38°E 85.65'  
Fnd PK Nail & Tag #24598 NW Sd 14" Red Pine N53°E 98.70'  
Fnd 36" Maple Stump S78°E 90'+  
Fnd Pointed Boulder S59°E 44.44'  
Fnd Form Nail N Sd P. Pole West 43.74'

See Back for Description C.

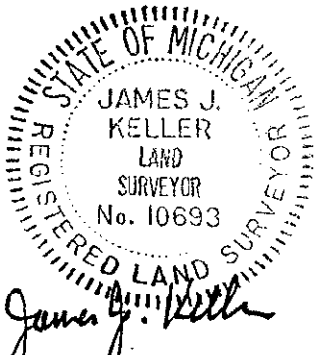

APPROVED BY MECOSTA CO. PEER GROUP  
IN ACCORDANCE WITH P.A. 345 of 1996

*James G. Knapp*  
CHAIRMAN  
DATE Nov. 13, 1998