

# SURVEY & REMONUMENTATION

## MAY 16 1996 MECOSTA COUNTY REMONUMENTATION PROGRAM

COMMISSION CORNER APPROVED BY PEER GROUP ON NOVEMBER 28, 1994

LAND CORNER RECORDATION CERTIFICATE  
Filing Requirement of Act 74, Mich. P.A. 1970

STATE OF MICHIGAN  
COUNTY OF MECOSTA  
RECEIVED FOR RECORD

For corners in  
MECOSTA  
(County)

Located In: \_\_\_\_\_ Corner Code # \_\_\_\_\_

1. Public Land Survey T 14N R 09W \_\_\_\_\_ A-9 \_\_\_\_\_  
T \_\_\_\_\_ R \_\_\_\_\_  
T \_\_\_\_\_ R \_\_\_\_\_  
T \_\_\_\_\_ R \_\_\_\_\_

2. Property Controlling S \_\_\_\_\_ T \_\_\_\_\_ R \_\_\_\_\_  
in Section S \_\_\_\_\_ T \_\_\_\_\_ R \_\_\_\_\_

3. Miscellaneous S \_\_\_\_\_ T \_\_\_\_\_ R \_\_\_\_\_  
Property in Sec. S \_\_\_\_\_ T \_\_\_\_\_ R \_\_\_\_\_

4. Lot No. \_\_\_\_\_, Recorded Plat \_\_\_\_\_

5. Private Claims \_\_\_\_\_

'96 MAY -2 P12:06

*Joann Brown*  
REGISTER OF DEEDS

Register of Deeds Stamp & File Number

I, JAMES G. KNAPP, in a field survey on OCTOBER 12, 1994, do hereby certify that under requirements of P.A. 74, Michigan P.A. of 1970, the corner points mentioned in lines 1 and 2 above were in conformance with regulations and rules therefore as required in the current manual of survey instructions of the United States Department of the Interior, Bureau of Land Management or by a decree of a Court of Law and/or that the corner points mentioned in lines 3, 4 and 5 above were in conformance with the rules of the Michigan Board of Land Surveyors or by a Decree of a Court of Law; established, re-established, monumented, re-monumented, recovered, found as expressed below:

	A	B	C	D	E	F	G	H	I	J	K	L	M
1													
2	6	6		4	3				2	1			
3													
4	7	8		9	10				11	12			
5													
6	18	17		16	15				14	13			
7													
8	19	20		21	22				23	24			
9													
10	30	29		28	27				26	25			
11													
12	31	32		33	34				35	36			
13													

NOTE: Only one corner may be recorded on this certificate.

A. Description of original monument and accessories and/or subsequent restoration:  
DEPUTY SURVEYOR, ABNER E. VANNESS, SET POST IN JAN. 1838, CORNER POST PLACED 40.00 CHAINS (2640 FEET) FROM 1/4 CORNER COMMON TO SECTIONS 25 AND 30 AND WITNESSED:  
MAPLE 12" S63°W 32 LINKS (21.12 FEET)  
BEECH 12" N75°W 21 LINKS (13.86 FEET)

ROAD SURVEY NOTES AT THE MECOSTA COUNTY ROAD COMMISSION (DRAWING NO. 110-3) BY W. H. WRIGHT, COUNTY ENGINEER, FROM ABOUT 1935, CALL FOR CORNER AS, "SEC. COR. IRON STK."

CORNER RECORDED IN LIBER 1, PAGE 451, AS PER P.A. 74 OF 1970, BY JOHN I. NELSON, P.S. 21273, ON SEPT. 20 1978, AND NOTED AS "FOUND 1" SQUARE HEAD BOLT", AND WITNESSED:

30" MAPLE	AZ. 75°	58.21'
12" MAPLE	AZ. 127°	102.79'
24" MAPLE	AZ. 210°	65.57'
12" MAPLE	AZ. 293°	89.52'

CORNER CALLED FOR AS PER P.A. 132 OF 1970, BY JOHN I. NELSON, P.S. 21273, IN LIBER 10, PAGE 636, AS "FOUND 1" SQUARE HEAD BOLT".

CORNER CALLED FOR AS PER P.A. 132 OF 1970, BY GERALD J. GRAY, P.S. 17741, IN LIBER 10, PAGE 901, ON SEPT. 25, 1980, AS "FND 1" SQ. HEAD BOLT", AND WITNESSED:


N75°E	58.21'	30" MAPLE
S53°E,	102.79'	12" TRIPLE MAPLE
S30°W,	65.57'	24" MAPLE

CORNER CALLED FOR AS PER P.A. 132 OF 1970, BY WILLIAM G. TINGLEY, P.S. 30104, IN LIBER 11, PAGE 811, ON JUNE 29, 1994.

APPROVED BY MECOSTA CO. PEER GROUP  
IN ACCORDANCE WITH P.A. 345 of 1990  
*James G. Knapp*  
CHAIRMAN  
DATE Nov. 28, 1994

B Description of corner evidence found and /or method applied in restoring or reestablishing corner  
FOUND 1" SQUARE HEAD X 3' LONG BOLT, INSIDE OF VITRIFIED TILE, BURIED 3" BELOW BITUMINOUS ROAD SURFACE. CORNER IS 1.5' WEST OF CENTERLINE OF 180TH. AVENUE, (24' BITUMINOUS) AND AT INTERSECTION WITH 8 MILE ROAD, IN LINE WITH CENTERLINE - WEST, (22' BITUMINOUS), AND 8' NORTH OF CENTERLINE - EAST, (22' BITUMINOUS).

C. Description of monument for corner and accessories established to perpetuate locating the position of the corner:  
A-9 - SECTION CORNER COMMON TO SECTIONS 19 AND 30, T14N-R09W, AND SECTIONS 24 AND 25, T14N-R10W.  
FOUND 1" SQUARE HEAD X 3' LONG BOLT, AND IS ACCEPTED AS A CAREFUL AND FAITHFUL PERPETUATION OF THE POSITION OF THE ORIGINAL CORNER.  
REMOVED THE 1" SQUARE HEAD X 3' LONG BOLT, AND SET IN THE SAME POSITION A STANDARD MECOSTA COUNTY REMONUMENTATION MONUMENT AND A HIGHWAY MONUMENT BOX.  
SET 60p SPIKE W/REMONUMENTATION TAG IN SOUTH SIDE OF 38" MAPLE AZ. 83°, 58.21 FEET (O.B.T.)  
SET 60p SPIKE W/REMONUMENTATION TAG IN S.W. SIDE OF 28" MAPLE AZ. 130°, 102.71 FEET  
SET 60p SPIKE W/REMONUMENTATION TAG IN N.W. SIDE OF 38" MAPLE AZ. 212°, 65.70 FEET (O.B.T.)  
SET 60p SPIKE W/REMONUMENTATION TAG IN NORTH SIDE OF 18" MAPLE AZ. 288°, 108.11 FEET

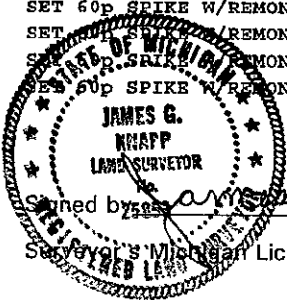

Signed by James G. Knapp Date MAY 1, 1996