

SURVEY & MECOSTA COUNTY REMONUMENTATION PROGRAM
REMONUMENTATION

CORNER APPROVED BY PEER GROUP ON NOVEMBER 28, 1994

OCT 29 1998

LAND CORNER RECORDATION CERTIFICATE

Filing Requirement of Act 74, Mich. P.A. 1970

STATE OF MICHIGAN
 COUNTY OF MECOSTA
 RECEIVED FOR RECORD

For corner in **SECTION**

MECOSTA
 (County)

Located In:

Corner Code #

1. Public Land Survey	T	14N	R	09W	B-11
	T		R		
	T		R		
	T		R		
2. Property Controlling in Section	S	T	R		
	S	T	R		
3. Miscellaneous Property in Sec.	S	T	R		
	S	T	R		

'98 AUG 19 A9:53

James Brown
 REGISTER OF DEEDS

Register of Deeds Stamp & File Number

4 Lot No. _____, Recorded Plat _____
 5. Private Claims _____

I, JAMES G. KNAPP, in a field survey on AUGUST 8, 1994, do hereby certify that under requirements of P.A. 74, Michigan P.A. of 1970, the corner points mentioned in lines 1 and 2 above were in conformance with regulations and rules therefore as required in the current manual of survey instructions of the United States Department of the Interior, Bureau of Land Management or by a decree of a Court of Law and/or that the corner points mentioned in lines 3, 4 and 5 above were in conformance with the rules of the Michigan Board of Land Surveyors or by a Decree of a Court of Law; established, re-established, monumented, re-monumented, recovered, found as expressed below:

	A	B	C	D	E	F	G	H	I	J	K	L	M
1													
2	6	5	4	3	2	1							
3													
4	7	8	9	10	11	12							
5													
6	18	17	16	15	14	13							
7													
8	19	20	21	22	23	24							
9													
10	30	29	28	27	26	25							
11													
12	31	32	33	34	35	36							
13													

NOTE: Only one corner may be recorded on this certificate.

A. Description of original monument and accessories and/or subsequent restoration:

DEPUTY SURVEYOR, ABNER E. VAN NESS, SET POST IN 1ST QUARTER 1838, NOTED CORNER AS, "SET 1/4 POST - HEMLOCK 20", AND BEING 39.00 CHAINS (2574.00 FEET) FROM S.W. CORNER AND 40.00 CHAINS (2640.00 FEET) FROM S.E. CORNER, SECTION 30.

CORNER RECORDED AS PER P.A. 74 OF 1970, BY GERALD J. GRAY, P.S. 17741, IN LIBER 1, PAGE 326, ON JUNE 10, 1976, AND NOTED CORNER AS, "SET 1/2" Ø IRON ON STRAIGHT LINE - NE TO NW.", AND WITNESSED:

N30°E	6" CHERRY	31.63'
S45°W	6" DOGWOOD	55.87'
	DUE NORTH GRADER BLADE	15.63'

CERTIFICATE OF SURVEY AS PER P. A. 132 OF 1970, BY JACK E. PIERSON, P.S. 19305, AND RECORDED IN LIBER 10, PAGE 579, ON AUG. 22, 1978, AND NOTES CORNER AS, "S. 1/4 COR. SEC. 30, AND WITNESSED:


8" W. ASH	N62°W	74.21'
6" CHERRY	N32°E	34.95'
8" BASSWOOD	S74°W	55.79'

CERTIFICATE OF SURVEY AS PER P. A. 132 OF 1970, BY JOHN I. NELSON, P.S. 21273, AND RECORDED IN LIBER 10, PAGES 635 - 639, ON SEPT. 20, 1978, AND NOTES CORNER AS, "FOUND RE-ROD W/R.L.S. CAP IN CENTER OF 7 MILE ROAD (20' GRAVEL), IN LINE WITH FENCE LINE NORTH AND SOUTH", AND WITNESSED:

6" CHERRY	AZ. 33°	34.8'
6" DOGWOOD	AZ. 254°	55.52'
GRADER BLADE	AZ. 09°	15.63'

**APPROVED BY MECOSTA CO. PEER GROUP
 IN ACCORDANCE WITH P.A. 74 OF 1970**

James G. Knapp
 CHAIRMAN
 DATE NOV. 28, 1994

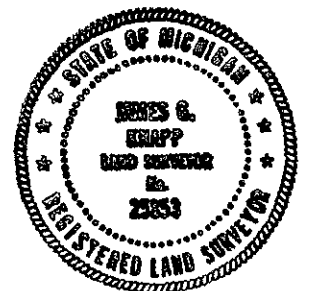

B. Description of corner evidence found and/or method applied in restoring or reestablishing corner:

FOUND 1/2" X 18" RE-BAR, 5" DEEP IN CENTER OF 7 MILE ROAD (20' GRAVEL), AND IN LINE WITH FENCE LINE NORTH AND SOUTH.

C. Description of monument for corner and accessories established to perpetuate locating the position of the corner:

B-11, 1/4 CORNER COMMON TO SECTIONS 30 AND 31, T14N-R09W.
 FOUND 1/2" X 18" RE-BAR, AND IS ACCEPTED AS A CAREFUL AND FAITHFUL RE-ESTABLISHMENT OF THE POSITION OF THE ORIGINAL CORNER.
 REMOVED THE 1/2" X 18" RE-BAR, AND PLACED IN THE SAME POSITION A STANDARD MECOSTA COUNTY REMONUMENTATION MONUMENT, WITH THE 1/2" X 18" RE-BAR INSIDE, BURIED 8" BELOW ROAD SURFACE, AND WITNESSED:

FOUND NAIL W/ TAG NO. 30104	IN NORTH SIDE OF 10" BASSWOOD (DEAD)	AZ. 254°	55.14 FEET
SET 60d SPIKE W/REMONUMENTATION TAG	IN WEST SIDE OF RAILROAD TIE FENCE POST	AZ. 182°	28.92 FEET
SET 60d SPIKE W/REMONUMENTATION TAG	IN N.W. SIDE OF 12" ELM	AZ. 26°	31.58 FEET
SET 60d SPIKE W/REMONUMENTATION TAG	IN N.E. SIDE OF 8" POPLAR	AZ. 128°	47.48 FEET

Signed by *James G. Knapp* Date JULY 20, 1998
 Surveyor's Michigan License No. 25853