

MECOSTA COUNTY REMONUMENTATION PROGRAM

CORNER APPROVED BY PEER GROUP ON JULY 22, 1993.

LAND CORNER RECORDATION CERTIFICATE

Filing Requirement of Act 74, Mich. P.A. 1970

For corners in
MECOSTA
 (County)

Located In: _____ Corner Code # _____

1. Public Land Survey T 14N R 09W _____
 T _____ R _____
 T _____ R _____
 T _____ R _____

2. Property Controlling S _____ T _____ R _____
 in Section S _____ T _____ R _____

3. Miscellaneous S _____ T _____ R _____
 Property in Sec. S _____ T _____ R _____

4 Lot No. _____ Recorded Plat _____

5. Private Claims _____

Joanne Brown
 Register of Deeds
 Mecosta County

'95 NOV -2 A11:12

Register of Deeds Stamp & File Number

	A	B	C	D	E	F	G	H	I	J	K	L	M
1													
2	6	5	4	3	2	1							
3													
4	7	8	9	10	11	12							
5													
6	18	17	16	15	14	13							
7													
8	19	20	21	22	23	24							
9													
10	30	29	28	27	26	25							
11													
12	31	32	33	34	35	36							
13													

I, JAMES G. KNAPP, in a field survey on SEPT. 12, 1991, do hereby certify that under requirements of P.A. 74, Michigan P.A. of 1970, the corner points mentioned in lines 1 and 2 above were in conformance with regulations and rules therefore as required in the current manual of survey instructions of the United States Department of the Interior, Bureau of Land Management or by a decree of a Court of Law and/or that the corner points mentioned in lines 3, 4 and 5 above were in conformance with the rules of the Michigan Board of Land Surveyors or by a Decree of a Court of Law; established, re-established, monumented, re-monumented, recovered, found as expressed below:

NOTE: Only one corner may be recorded on this certificate.

A. Description of original monument and accessories and/or subsequent restoration:
 DEPUTY SURVEYOR, ABNER E. VANNESS, SET POST IN JAN. 1838. CORNER PLACED AT 40.00 CHAINS (2640 00 FEET) FROM W.1/4 CORNER SECTION 36 AND WITNESSED:

- BEECH 10" N42°W 25 Links (16.50 Feet)
- BEECH 12" S67°W 20 Links (13.20 Feet)

SURVEYOR'S RECORD BOOK NO. 1, ON PAGE 99 AT REGISTER OF DEEDS OFFICE, SHOW NOTES BY L.W. JUNE, COUNTY SURVEYOR, IN FEB. 1902, CORNER NOTED AS, "STONE CORNER" AND WITNESSED:
 BLACK OAK 10" S72°E 52 LINKS (34.32 FEET)

COUNTY SURVEYOR RECORD BOOK NO. 1, ON PAGE 163, AT REGISTER OF DEEDS OFFICE, SHOW NOTE BY WALTER W. WILLITS, COUNTY SURVEYOR, IN JUNE 1913, AND NOTED CORNER AS, "IRON STAKE - STONE".

ROAD SURVEY NOTES AT MECOSTA CO. ROAD COMMISSION SHOW THE FOLLOWING:

1. IN OCT. 1920, NOTES BY D.L. FOSTER SHOW CORNER WITNESSED
 MAPLE S45°E 36.8'
 STUMP S18°E 87.8'
 AND A DISTANCE OF 2663.5' SOUTH TO 1/4 CORNER SECTION 35 & 36.
2. IN OCT., 1921 NOTES BY H.F. ANDERSON SHOW CORNER AS, "STAKE", & WITNESSED:
 20" OAK S.E. 36.5'4.8'
 TEL. GUY POLE N.W. 33.6'
 CORNER FENCE POST S.W. 34'
 AND A DISTANCE OF 2,651.6 FEET TO THE W. 1/4 CORNER SECTION 25.
3. IN MAY 1927, NOTES BY E. E. SOURS, SHOW CORNER WITNESSED AS:
 OAK 18" S44°-30'E 36.0'
 R. MAPLE 5" S61°-00'W 48.0'
 AND A DISTANCE OF 2,652.6 FEET TO THE W.1/4 CORNER SECTION. 25.

APPROVED BY MECOSTA CO. PEER GROUP
 IN ACCORDANCE WITH P.A. 345 of 1990

James G. Knapp
 CHAIRMAN
 DATE July 22, 1993


B. Description of corner evidence found and/or method applied in restoring or reestablishing corner:
 FOUND 8" X 10" POINTED STONE, BURIED 16" BELOW GRAVEL ROAD SURFACE, 3' WEST OF CENTER OF 130th AVE. (22' GRAVEL) & IN LINE WITH CENTER OF 7 MILE ROAD (20' GRAVEL) WEST & ABANDONED ROADBED - EAST.
 FOUND DECAYED REMAINS OF 24" MAPLE STUMP AT S61°W, 48.4'. FOUND "STONE", FITS WITH RECORDED DISTANCE TO W. 1/4 SECTION 25, 2652.6 FEET & 2651.6 FEET RECORDED TO 2651.37 FEET MEASURED. AFTER ROAD RECONSTRUCTION IN 1992, CORNER IS IN CENTERLINE OF 130th. AVE. (22' BITUMINOUS).

C. Description of monument for corner and accessories established to perpetuate locating the position of the corner:
 K-11 - SECTION CORNER COMMON TO SECTIONS 25, 26, 35, AND 36. T14N-R09W
 FOUND 8" X 10" POINTED STONE AND IS ACCEPTED AS A CAREFUL AND FAITHFUL PERPETUATION OF THE ORIGINAL CORNER.

REMOVED 8" X 10" STONE AND SET IN THE SAME POSITION A STANDARD MECOSTA COUNTY REMONUMENTATION MONUMENT, AND A HIGHWAY MONUMENT BOX.

- SET 60p SPIKE W/REMONUMENTATION WITNESS TAG IN S.E. SIDE UTILITY POLE AZ. 48°, 52.30 FEET.
- SET 60p SPIKE W/REMONUMENTATION WITNESS TAG IN NORTH SIDE 20" BLACK OAK AZ. 102°, 63.83 FEET
- SET 60p SPIKE W/REMONUMENTATION WITNESS TAG IN WEST SIDE UTILITY POLE AZ. 164°, 126.10 FEET
- SET 60p SPIKE W/REMONUMENTATION WITNESS TAG IN N.E. SIDE UTILITY POLE AZ. 315°, 92.05 FEET

Signed by James G. Knapp Date Nov. 2, 1993
 Surveyor's Michigan License No. 25853

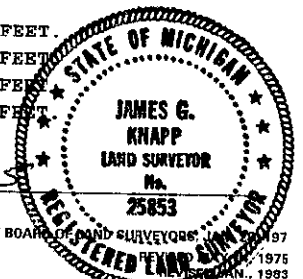

FORM APPROVED BY MICHIGAN STATE BOARD OF LAND SURVEYORS, JAN. 1977