

**SURVEY & REMONUMENTATION**  
**MECOSTA COUNTY REMONUMENTATION PROGRAM**

NOV 18 1997 CORNER APPROVED BY PEER GROUP ON OCTOBER 10, 1997

COMMISIONER

**LAND CORNER RECORDATION CERTIFICATE**  
**Filing Requirement of Act 74, Mich. P.A. 1970**

For corners in MECOSTA (County)	Located In:	Corner Code #
1. Public Land Survey	T 14N R 09W	K-13
	T _____ R _____	_____
	T _____ R _____	_____
	T _____ R _____	_____
2. Property Controlling in Section	S _____ T _____ R _____	_____
	S _____ T _____ R _____	_____
3. Miscellaneous Property in Sec.	S _____ T _____ R _____	_____
	S _____ T _____ R _____	_____
4. Lot No. _____, Recorded Plat _____		
5. Private Claims _____		

STATE OF MICHIGAN  
 COUNTY OF MECOSTA  
 RECEIVED FOR RECORD

'97 NOV -7 P2:23

*James G. Knapp*  
 REGISTER OF DEEDS  
 Register of Deeds Stamp & File Number

I, JAMES G. KNAPP, in a field survey on SEPTEMBER 11, 1993, do hereby certify that under requirements of P.A. 74, Michigan P.A. of 1970, the corner points mentioned in lines 1 and 2 above were in conformance with regulations and rules therefore as required in the current manual of survey instructions of the United States Department of the Interior, Bureau of Land Management or by a decree of a Court of Law and/or that the corner points mentioned in lines 3, 4 and 5 above were in conformance with the rules of the Michigan Board of Land Surveyors or by a Decree of a Court of Law; established, re-established, monumented, re-monumented, recovered, found as expressed below:

	A	B	C	D	E	F	G	H	I	J	K	L	M
1													
2	6	5	4	3	2	1							
3													
4	7	8	9	10	11	12							
5													
6	18	17	16	15	14	13							
7													
8	19	20	21	22	23	24							
9													
10	30	29	28	27	26	25							
11													
12	31	32	33	34	35	36							
13													

**NOTE: Only one corner may be recorded on this certificate.**

**A. Description of original monument and accessories and/or subsequent restoration:**

DEPUTY SURVEYOR, JOHN HODGSON, SET POST IN 1837. CORNER POST PLACED 40.00 CHAINS (2640.00 FEET) FROM SOUTH 1/4 CORNER SECTION 36, AND WITNESSED: PINE 18" N42°E 26 LINKS (17.16 FEET)  
 BEECH 12" N41°W 08 LINKS (5.28 FEET)

SURVEY NOTES OF SECTION 36, FROM COUNTY SURVEYORS RECORD BOOK NO. 1, PAGE 163, AT REGISTER OF DEEDS OFFICE, BY WALTER W. WILLITS, COUNTY SURVEYOR, DATED JUNE 1913, SHOW A DISTANCE OF 2642.00 FEET TO THE SOUTH 1/4 CORNER AND A DISTANCE OF 2634.00 FEET TO THE WEST 1/4 CORNER OF SECTION 36, WITH CORNER NOTED, AS, "IRON PIN", AND WITNESSED:  
 BEECH 13" N73°W 97'  
 POPLLE 6" S55°E 95'

MECOSTA COUNTY ROAD COMMISSION NOTES, DATED NOV. 3 - 4, 1920, BY D. L. FOSTER, NOTES A DISTANCE OF 5,275 FEET FROM THE N.W. TO THE S.W. CORNER OF SECTION 36.

APPROVED BY MECOSTA CO. PEER GROUP  
 IN ACCORDANCE WITH P.A. 345 of 1990

*James G. Knapp*  
 CHAIRMAN  
 DATE OCT. 10, 1997

**B. Description of corner evidence found and/or method applied in restoring or reestablishing corner:**


FOUND 1" SQUARE IRON PIN, BURIED 2.1 FEET BELOW GRAVEL ROAD SURFACE, AT ROAD INTERSECTION IN LINE W/ 130<sup>TH</sup>. AVENUE - NORTH, AND 6 MILE ROAD - WEST, ON SEPT. 15, 1991.  
 AFTER ROAD RECONSTRUCTION AND BITUMINOUS PAVING ON JUNE 15, 1994, CORNER IS ON CURVE TANGENT AND 2.2 FEET WEST OF CENTERLINE OF 130<sup>TH</sup>. AVENUE (22' BITUMINOUS), AND IN LINE WITH 130<sup>TH</sup>. AVENUE (26' GRAVEL - WEST)  
 MEASURED DISTANCE TO THE SOUTH 1/4 CORNER IS 2647.07 FEET, AND TO THE WEST 1/4 CORNER IS 2635.33 FEET OF SECTION 36.

**C. Description of monument for corner and accessories established to perpetuate locating the position of the corner:**

K-13 - CORNER COMMON TO SECTIONS 35 AND 36, T14N-R09W.  
 FOUND, 1" SQUARE IRON PIN, BURIED 2.1 FEET BELOW ROAD, AND IS ACCEPTED AS A CAREFUL AND FAITHFUL PERPETUATION OF THE POSITION OF THE ORIGINAL CORNER.  
 PLACED A STANDARD MECOSTA COUNTY REMONUMENTATION MONUMENT, AND A HIGHWAY MONUMENT BOX, (OVER THE 1" SQUARE IRON PIN) WHILE BITUMINOUS PAVING OF 130<sup>TH</sup>. AVENUE ON JUNE 15, 1994.  
 SET 60d SPIKE W/REMONUMENTATION TAG IN WEST SIDE OF 14" BOX ELDER  
 S.W. CORNER OF HOUSE  
 CORNER COMMON TO SECTIONS 1 AND 2, T13N-R09W (COUNTY REMONUMENTATION MONUMENT)  
 SET 60d SPIKE W/REMONUMENTATION TAG IN NORTH SIDE OF UTILITY POLE

AZ. 11°	104.20 FEET
AZ. 35°	113.62 FEET
AZ. 88°	99.14 FEET
AZ. 112°	162.94 FEET

Signed by James G. Knapp Date MARCH 20, 1997  
 Surveyor's Michigan License No. 25853

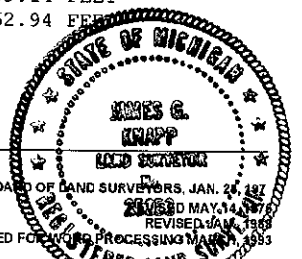

FORM APPROVED BY MICHIGAN STATE BOARD OF LAND SURVEYORS, JAN. 28, 1977  
 REVISED MAY 14, 1997  
 REVISED JAN 1993  
 ADAPTED FROM FORM PROCESSING MANUAL, 1993