LAND CORNER RECORDATION CERTIFICATE

Filing Requirement of Act 74, Mich. P.A. 1970

For corners in
MECOSTA
(County)

		Located In:	Corner Code ##
1. Public Land Survey		T 14NR 10W	H-5,H-6
		T ___ R ___	
		T ___ R ___	
		T ___ R ___	
2. Property Controlling	S ___	T ___ R ___	
in Section	S ___	T ___ R ___	
3. Miscellaneous	S ___	T ___ R ___	
Property in Sec.	S ___	T ___ R ___	

Register of Deeds Stamp & File Number

4. Lot No. _____ , Recorded Plat _____
5. Private Claims _____

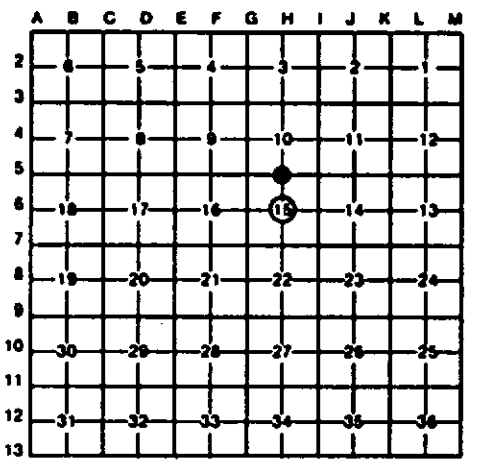

I, C.F.ROSER, in a field survey on MAY. 5, 19 92, do hereby certify that under requirements of P.A. 74, Michigan P.A. of 1970, the corner points mentioned in lines 1 and 2 above were in conformance with regulations and rules therefore as required in the current manual of survey instructions of the United States Department of the Interior, Bureau of Land Management or by a decree of a Court of Law and/or that the corner points mentioned in lines 3, 4 and 5 above were in conformance with the rules of the Michigan Board of Land Surveyors or by a Decree of a Court of Law; established, re-established, monumented, re-monumented, recovered, found as expressed below:

NOTE: Not more than 4 corners, all in the same town and range, may be recorded on this certificate.

A. Description of original monument and accessories and/or subsequent restoration:

H-5 H-6

B. Description of corner evidence found and/or method applied in restoring or reestablishing corner:

H-5	H-6
REESTABLISHED N1/4 COR SEC. 15 PER MDOT NITS AND SURVEY DATA 1/2 MILE N AND S. COR IS IN LINE WITH OLD FENCE WEST AND 12' EAST OF CTR N-S GRAVEL RD.	FD OLD PIPE FOR CTR OF SEC 15 AS NOTED AN MDOT MAP, JOB. NO.16246A, SHEET 36, DATED 8-80. COR IS IN LINE WITH CTR OF GRAVEL RD LOOKING N. AND 20' W. OF W'LY ROW FN OF US-131 (CTR SB US-131 IS 180' EAST).

C. Description of monument for corner and accessories established to perpetuate locating the position of the corner:

H-5			H-6		
DRIVE 5/8" x 34" REROD W/LS CAP.			FD OLD 3/4" PIPE; REPLACED WITH 1"x 36" GALV. PIPE W/LS CAP.		
#17" S.MAPLE	S50°W	57.02'	#12"W.PINE	N60°W	38.75'
#38" S.MAPLE	S25°W	69.08'	11"W.PINE	N25°W	42.94'
16" W.PINE	S85°E	78.24'	13"W.PINE	N25°E	40.78'
9" R.PINE	S75°W	53.62'	#23"W.PINE	S10°W	76.12'

#= MDOT NIT. #= MDOT NIT.

STATE OF MICHIGAN
CARL F. ROSER
LAND SURVEYOR
No. 12028
REGISTERED LAND SURVEYOR

Signed by Carl F. Roser 3-11-93 Date _____

Surveyor's Michigan License No. 12028

FORM APPROVED BY MICHIGAN STATE BOARD OF LAND SURVEYORS, JAN. 28, 1971
REVISED MAY 14, 1975
REVISED JAN., 1983