

MECOSTA COUNTY REMONUMENTATION PROGRAM
CORNER APPROVED BY PEER GROUP ON November 14, 1997

STATE OF MICHIGAN
 COUNTY OF MECOSTA
 RECEIVED FOR RECORD

LAND CORNER RECORDATION CERTIFICATE
Filing Requirement of Act 74, Mich. P.A. 1970

'97 DEC 22 A8:42

For corners in Mecosta <small>(County)</small>	Located In: Mecosta Township	Corner Code # F-13
1. Public Land Survey	SEC 33 T14N R10W	
	T R	
	T R	
	T R	
2. Property Controlling in Section	S T R	
	S T R	
3. Miscellaneous Property in Sec.	S T R	
	S T R	
4. Lot No. _____, Recorded Plat _____		
5. Private Claims _____		

Journal Brown
 REGISTER OF DEEDS

Register of Deeds Stamp & File Number

I, James J. Keller, in a field survey on August 19 97, do hereby certify that under requirements of P.A. 74, Michigan P.A. of 1970, the corner points mentioned in lines 1 and 2 above were in conformance with regulations and rules therefore as required in the current manual of survey instructions of the United States Department of the Interior, Bureau of Land Management or by a decree of a Court of Law and/or that the corner points mentioned in lines 3, 4 and 5 above were in conformance with the rules of the Michigan Board of Land Surveyors or by a Decree of a Court of Law; established, re-established, monumented, re-monumented, recovered, found as expressed below:

NOTE: Not more than 4 corners, all in the same town and range, may be recorded on this certificate.

A. Description of original monument and accessories and/or subsequent restoration:

June 29, 1837, John Hodgson, Deputy Surveyor G.L.O. "Set Quarter Section Post"
 10" Beech N37°E 13 Links (11.88') 8" Beech N31°W 29 Links (19.14')

May 28, 1910, Lyman W. June, Mecosta County Surveyor, Field Book 8, Pages 152-153
 No Witnesses Given

June 3-14, 1920, C.H. Freeman, Surveyor Record Book No. 1, Page 197
 No Witnesses Given

B. Description of corner evidence found and/or method applied in restoring or reestablishing corner:


November 13, 1997, James J. Keller R.L.S. #10693, Searched for but did not find direct evidence of the Corner. Considered Corner as Lost and Set 1/2" Rebar on Line and midway between G-13 and E-13

C. Description of monument for corner and accessories established to perpetuate locating the position of the corner:

Accepted and Set Remonumentation Monument as a Careful and Faithful Reestablishment of the Position of the Original Corner.

- Set 60d and Tag NE side 12" White Pine N55°W 21.87'
- Set 60d and Tag E side 6" Cherry N24°W 11.70'
- Set 60d and Tag W side 10" Oak S03°W 29.93'
- Set 60d and Tag NW side 14" White Pine S59°W 22.04'
- N1/4 Cor 4-13-10 (Remon Mon) N89°37'12"E 95.88'

SURVEY & REMONUMENTATION
 FEB 26 1998
 SECTION

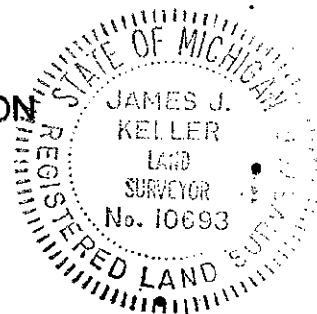

Signed by James J. Keller Date December 2, 1997
 Surveyor's Michigan License No. 10693

FORM APPROVED BY MICHIGAN STATE BOARD OF LAND SURVEYORS, JAN. 28, 1974.
 REVISED MAY 14, 1975
 REVISED JAN. 1983
 ADAPTED FOR WORD PROCESSING MARCH, 1993

APPROVED BY MECOSTA CO. PEER GROUP
 IN ACCORDANCE WITH P.A. 345 of 1990


James H. Knapp
 CHAIRMAN
 DATE Nov. 14, 1997

LIBER 100 PAGE 335

Dec, 2, 1997

LJH

as set

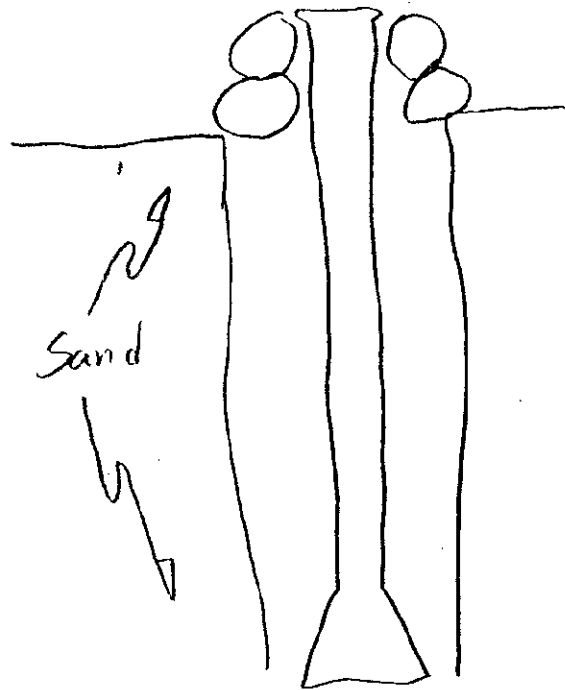

Set mon 6"
Above Ground
with small stones
around the top of
the mon

SURVEY &
REMONUMENTATION

FEB 26 1998

SECTION