

SURVEY &  
REMONUMENTATION

MECOSTA COUNTY REMONUMENTATION PROGRAM

MAR 14 2000

CORNER APPROVED BY PEER GROUP ON December 3, 1999 STATE OF MICHIGAN  
COUNTY OF MECOSTA  
RECEIVED FOR RECORD

SECTION

LAND CORNER RECORDATION CERTIFICATE

Filing Requirement of Act 74, Mich. P.A. 1970

'99 DEC 10 P2:59

For corners in	Located in:	Corner Code #
Mecosta (County)	Mecosta Twp.	
1. Public Land Survey	SEC 15 T 14N R 10W	G-6
	T _____ R _____	_____
	T _____ R _____	_____
	T _____ R _____	_____
2. Property Controlling in Section	S _____ T _____ R _____	_____
	S _____ T _____ R _____	_____
3. Miscellaneous Property in Sec.	S _____ T _____ R _____	_____
	S _____ T _____ R _____	_____

*Joan Brown*  
REGISTER OF DEEDS

Register of Deeds Stamp & File Number

4. Lot No. \_\_\_\_\_, Recorded Plat \_\_\_\_\_  
5. Private Claims \_\_\_\_\_

I, James J. Keller, in a field survey on August 12, 1999, do hereby certify that under requirements of P.A. 74, Michigan P.A. of 1970, the corner points mentioned in lines 1 and 2 above were in conformance with regulations and rules therefore as required in the current manual of survey instructions of the United States Department of the Interior, Bureau of Land Management or by a decree of a Court of Law and/or that the corner points mentioned in lines 3, 4 and 5 above were in conformance with the rules of the Michigan Board of Land Surveyors or by a Decree of a Court of Law; established, re-established, monumented, re-monumented, recovered, found as expressed below:

	A	B	C	D	E	F	G	H	I	J	K	L	M
1													
2	6	5	4	3	2	1							
3													
4	7	8	9	10	11	12							
5													
6	18	17	16	15	14	13							
7													
8	19	20	21	22	23	24							
9													
10	30	29	28	27	26	25							
11													
12	31	32	33	34	35	36							
13													

NOTE: Not more than 2 corners, all in the same town and range, may be recorded on this certificate.

A. Description of original monument and accessories and/or subsequent restoration:

- March 1, 1898, Abner E. Van Ness, Deputy Surveyor GLO. "To Sec. Cor. on a Beech 7in. Diam."
- December 13, 1926, William Fargo, Consumers Power Co. DWG F-5618. Noted Corner not found.
- July 1956, Wilborn W. Wright, County Surveyor (Record Book 1 P218). No Witnesses Given.
- June 1967, George Blass, RLS #5489. Survey notes for E-W 1/4 line Sec. 15-14-10. No witnesses given for W 1/4 corner.
- June 1, 1972, Patrick A. Salisbury, RLS #13594 (Survey L10 P44) "Pd Lead Capped Pipe"  
Nail 12" Maple N75°W 20.95' Nail 24" Oak Due South 103.15' Nail 16" Oak S35°E 72.82'
- October 27, 1975, Douglas W. Hooth, RLS #7966, MSHD Surveyor (LCRC Li P201) "Iron from old Co Rd Comm. records."  
Found 1" Iron 6" below surface. North edge of trail, & in line with Fe. South"  
15" Ash S55°E 33.23' 10" W. Pine N15°E 43.53' 16" Maple N70°W 21.15'
- April 16, 1981, Duane F. Wood, RLS #24625 (Survey L10 P942) Ran S 1/8th Line E of E 1/8th Ln. No Witnesses Given.

B. Description of corner evidence found and/or method applied in restoring or reestablishing corner:


August 12, 1999, James J. Keller, RLS #10693 (PB138-W P95) "Leaded pipe called in L10 P44 not found. Set 1/2" Rebar by witnesses."

- Found Nail & MSHD Tag SW sd 6"-7"-6" Tri Ash S47°E 28.32'
- Found Nail & Tag #13594 S. sd 18" Maple N65°W 20.95'
- Found Nail & Flagging W. sd 24" W. Oak S07°W 103.15'
- Set 30d E sd 10" Red Pine N22°E 44.90'
- SE Corner 4x6" I gate post N17°W 13.18'

C. Description of monument for corner and accessories established to perpetuate locating the position of the corner:

Accepted Witnesses by MSHD and Set Remonumentation Monument as a careful and faithful perpetuation of the position of the original corner.

- Found 30d and set 60d and tag E. sd 10" Red Pine N22°E 44.90'
- Found Nail & MSHD Tag SW sd 6"-7"-6" Tri Ash S47°E 28.32'
- Found Nail & Tag #13594 and set 60d and tag above S. sd 18" Maple N65°W 20.95'
- Found 30d and set 60d and tag W. sd 24" W. Oak S07°W 103.15'

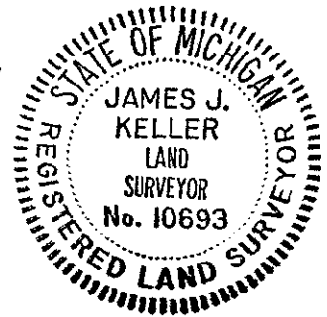

Signed by James J. Keller Date December 6, 1999  
Surveyor's Michigan License No. 10693

FORM APPROVED BY MICHIGAN STATE BOARD OF LAND SURVEYORS, JAN. 28, 1971  
REVISED MAY 11, 1975  
REVISED JAN. 1983  
ADAPTED FOR WORD PROCESSING MARCH, 1983

APPROVED BY MECOSTA CO. PEER GROUP  
IN ACCORDANCE WITH P.A. 345 of 1990  
James J. Knapp  
CHAIRMAN  
DATE DEC. 3, 1999

SURVEY &  
REMONUMENTATION

MAR 14 2000

SECTION October - 18 - 1999

LJH CH

