

SURVEY &
REMONUMENTATION

MAR 03 1999

MECOSTA COUNTY REMONUMENTATION PROGRAM

SECTION

CORNER APPROVED BY PEER GROUP ON October 9, 1998

LAND CORNER RECORDATION CERTIFICATE

Filing Requirement of Act 74, Mich. P.A. 1970

STATE OF MICHIGAN
COUNTY OF MECOSTA
RECEIVED FOR RECORD

'98 DEC 28 A8:37

For corners in

| Mecosta (County) | Located in: Mecosta Twp | Corner Code # |
|---------------------------------------|---|--------------------------------|
| 1. Public Land Survey | SEC 21 T14N R10W T _____ R _____ T _____ R _____ T _____ R _____ | G-7 _____ _____ _____ |
| 2. Property Controlling in Section | S _____ T _____ R _____ S _____ T _____ R _____ | _____ _____ |
| 3. Miscellaneous Property in Sec. | S _____ T _____ R _____ S _____ T _____ R _____ | _____ _____ |

Joan Brown
REGISTER OF DEEDS

Register of Deeds Stamp & File Number

4. Lot No. _____, Recorded Plat _____
5. Private Claims _____

I, James J. Keller, in a field survey on October 8, 19 98, do hereby certify that under requirements of P.A. 74, Michigan P.A. of 1970, the corner points mentioned in lines 1 and 2 above were in conformance with regulations and rules therefore as required in the current manual of survey instructions of the United States Department of the Interior, Bureau of Land Management or by a decree of a Court of Law and/or that the corner points mentioned in lines 3, 4 and 5 above were in conformance with the rules of the Michigan Board of Land Surveyors or by a Decree of a Court of Law; established, re-established, monumented, re-monumented, recovered, found as expressed below:

NOTE: Not more than 2 corners, all in the same town and range, may be recorded on this certificate.

A. Description of original monument and accessories and/or subsequent restoration:

- February 25, 1938, Abner E. VanNess, Deputy Surveyor GLO "Set Post Cor. to Sect 15, 16, 21 & 22"
10" Hemlock N60°E 6 Links (3.96') 12" Hemlock S60°E 21 Links (13.86')
- December 1, 1926, Wm Fargo, Consumers Power Company Dwg #F-5613-E "Accepted old Stake & Stone. Set Tile"
(No Witnesses Given)
- December 13, 1926, Wm Fargo, Consumers Power Company Dwg #F-5618 "Accepted old Stake and Stone"
24" Old Pine Stump N31-1/2°E 43 Links (28.38')
36" Old Pine Stump N 75-1/4°E 1.77-1/4 Ch (116.98')
- October 27, 1975, Douglas W. Booth, RLS #7966 MSHD (LCRC L1 P213) "Found Concrete Filled Tile in Fence Corner, Fence E & N, Trail West."
17" Tw. Oak N10°W 70.21' 14" Pine N80°W 57.76'
7" S Pine S35°E 6.20' 7" S Pine S35°W 11.46'

B. Description of corner evidence found and/or method applied in restoring or reestablishing corner:

- October 8, 1998, James J. Keller, RLS #10693 (FB 138-W, P66) "Found 4" Tile Filled With Concrete With Cross Cut in Top"
Found 12"-14" Twin Oak N04°W 70.21' (No Nail Found)
Found 9" Scotch Pine S35°E 6.20' (No Nail Found)
Found MSHD Tag 10" Scotch Pine S39°W 11.46'
Found 14" Scotch Pine N74°W 57.76' (No Nail Found)


C. Description of monument for corner and accessories established to perpetuate locating the position of the corner:

Accepted Tile and Set Remonumentation Monument as a Careful and Faithful Perpetuation of the Position of the Original Corner.

- Set 60d & Tag E Sd 12"-14" Twin Oak N04°W 70.21'
Set 60d & Tag E Sd 9" Scotch Pine S35°E 6.20'
Set 60d & Tag Above MSHD Nail & Tag NW Sd 10" Scotch Pine S39°W 11.46'
Set 60d & Tag N Sd 14" Scotch Pine N74°W 57.76'

APPROVED BY MECOSTA CO. PEER GROUP
IN ACCORDANCE WITH P.A. 345 of 1990

James J. Knapp
CHAIRMAN
DATE OCT. 9, 1998

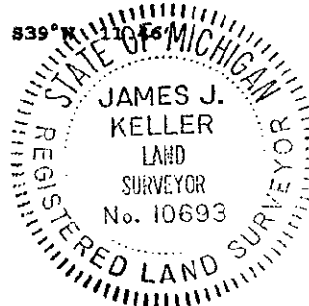

Signed by James J. Keller Date October 15, 1998

Surveyor's Michigan License No. 10693

FORM APPROVED BY MICHIGAN STATE BOARD OF LAND SURVEYORS, JAN 28, 1971
REVISED MAY 14, 1975
REVISED JAN, 1983
ADAPTED FOR WORD PROCESSING MARCH, 1993

10-15-1998

MAR 03 1999

JJK LJH TMB

SECTION

