

MAR 14 2000

**MECOSTA COUNTY REMONUMENTATION PROGRAM** STATE OF MICHIGAN  
COUNTY OF MECOSTA  
CORNER APPROVED BY PEER GROUP ON October 8, 1999 RECEIVED FOR RECORD

SECTION

**LAND CORNER RECORDATION CERTIFICATE**

Filing Requirement of Act 74, Mich. P.A. 1970

'99 NOV 15 P2:40

For corners in

Mecosta  
(County)

Located in:

Mecosta Twp.

Corner Code #

*James Brown*  
REGISTER OF DEEDS

1. Public Land Survey	SEC 22 T 14N R 10W	G-8
	T R	
	T R	
	T R	
2. Property Controlling in Section	S T R	
	S T R	
3. Miscellaneous Property in Sec.	S T R	
	S T R	

Register of Deeds Stamp & File Number

4. Lot No. \_\_\_\_\_, Recorded Plat \_\_\_\_\_  
5. Private Claims \_\_\_\_\_

I, James J. Keller in a field survey on October 7, 1999, do hereby certify that under requirements of P.A. 74, Michigan P.A. of 1970, the corner points mentioned in lines 1 and 2 above were in conformance with regulations and rules therefore as required in the current manual of survey instructions of the United States Department of the Interior, Bureau of Land Management or by a decree of a Court of Law and/or that the corner points mentioned in lines 3, 4 and 5 above were in conformance with the rules of the Michigan Board of Land Surveyors or by a Decree of a Court of Law; established, re-established, monumented, re-monumented, recovered, found as expressed below:

A	B	C	D	E	F	G	H	I	J	K	L	M
2	6	5	4	3	2	1						
3												
4	7	8	9	10	11	12						
5												
6	18	17	16	15	14	13						
7												
8	19	20	21	22	23	24						
9												
10	30	29	28	27	26	25						
11												
12	31	32	33	34	35	36						
13												

NOTE: Not more than 2 corners, all in the same town and range, may be recorded on this certificate.

A. Description of original monument and accessories and/or subsequent restoration:

February 25, 1838, Abner E. Van Ness, Deputy Surveyor GLO "Set Gr. Sec. Post"  
6" Beech N46°W 19 Links (12.54') 5" Beech S56-1/2° 10 Links (6.60')

December 13, 1926, William Fargo, CPro Surveyor, Commonwealth & Southern Dwg #F-5618 "Accepted Stake & Stone. Set Tile"  
28" Pine Stump N60-1/2°E 92-1/4 Links (61.05') Pine Stump S55°E 134-1/2 Links (88.77')

September 18, 1967, George W. Blass, RLS #5489 (Survey L10 P559) No Witnesses Given.

September 22, 1972, Patrick A. Salisbury, RLS #13594 (LCRC L1 P33) "Found East 1/4 corner of Section 21: A Red Fence Post driven in ground and protruding 1-1/2 feet above the ground. Witness trees also painted red and the Section line to the South is Marked by red paint on adjacent trees".  
10" White Oak N60°E 4.80' 14" White Pine S23°W 16.00'  
14" White Oak S37°E 21.85'

October 27, 1975, Douglas W. Hooth, RLS #7966, MSHD Surveyor (LCRC L1 P202) "From Consumers Power Co. Records, Fnd stake & stone & set tile 1926. Found 4" Conc. filled tile in Fe line West & Fe row East"  
10" W. Cherry S85°E 35.82' 10" R. Pine S15°W 19.65'  
P.Pole N15°W 35.81' 12" Oak Due West 59.37'

B. Description of corner evidence found and/or method applied in restoring or reestablishing corner:

October 7, 1999, James J. Keller, RLS #10693 (FB138-W P105) "Found 6" Clay tile filled with concrete and + on top."  
Set 60d S. sd 16" W. Cherry S83°E 35.73' Found MSHD tag W. sd 14" R. Pine S15°W 19.65'  
Set 60d N. sd 18" Oak N85°W 59.15' Found 40d W. sd P.Pole N15°W 36.29'


C. Description of monument for corner and accessories established to perpetuate locating the position of the corner:

Accepted 6" Clay tile and set Remonumentation Monument as a careful and faithful perpetuation of the position of the original corner.

Found 60d and set tag S. sd 16" W. Cherry S85°E 35.73'  
Found MSHD tag and set 60d and tag above W. sd 14" R. Pine S15°W 19.65'  
Found 60d and set tag N. sd 18" Oak N85°W 59.15'  
Found 40d and set PK nail and tag above W. sd P.Pole N15°W 36.29'

APPROVED BY MECOSTA CO. PEER GROUP  
IN ACCORDANCE WITH P.A. 345 of 1990

*James J. Knapp*  
CHAIRMAN  
DATE Oct. 8, 1999

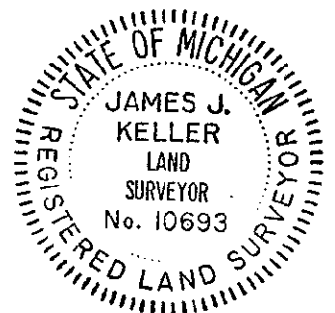

Signed by James J. Keller  
Surveyor's Michigan License No. 10693

Date October 21, 1999


MAR 14 2000

SECTION

October - 18 - 1999

LJH CH

Found 6" clay tile in  
Nest of Stones

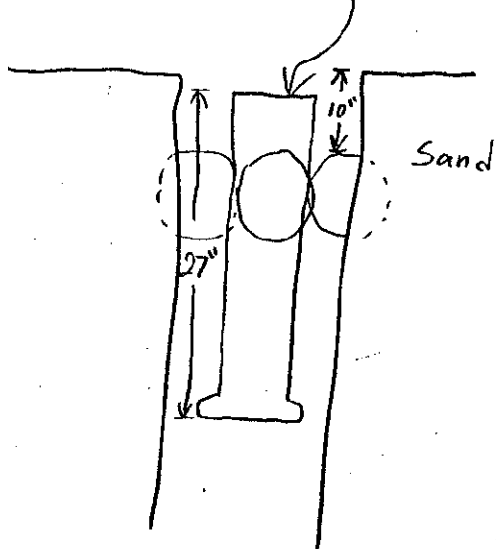

Set monument in Nest of  
Stones at surface

